


T. 2S, R. 44E, W.M.

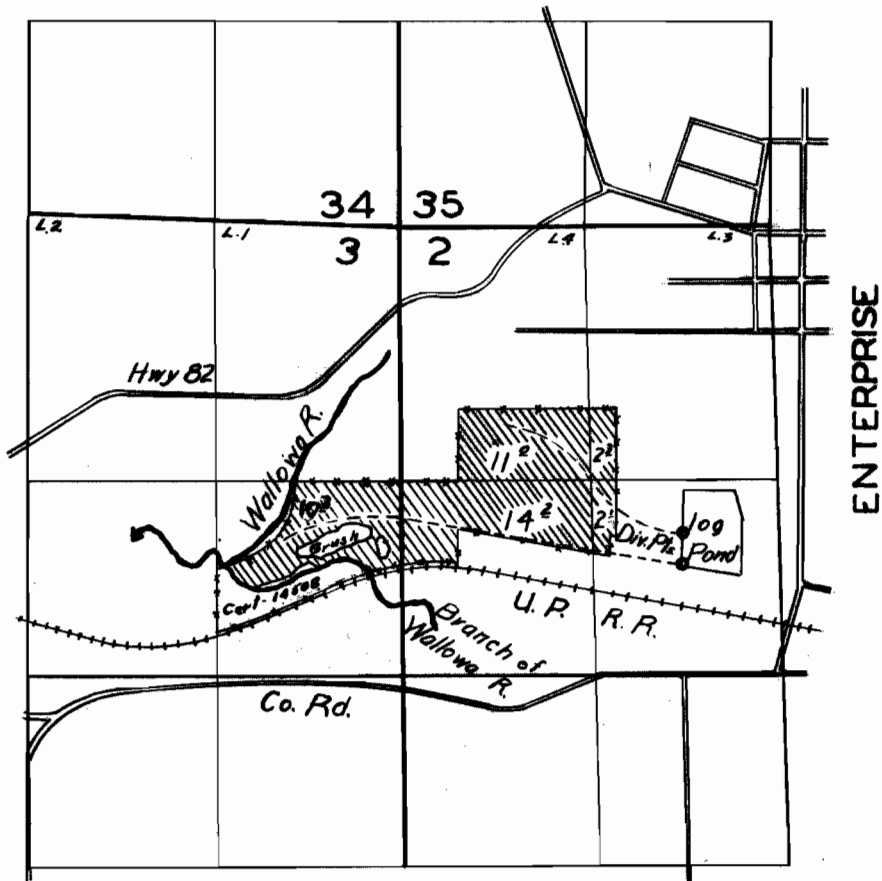

FINAL PROOF SURVEY
UNDER

Application No. 18900... Permit No. 14588...
IN NAME OF

SAM W & ILMA R. SHINN

Surveyed 9 August 1955, by *Robert H. [Signature]*