


T15R9WWM

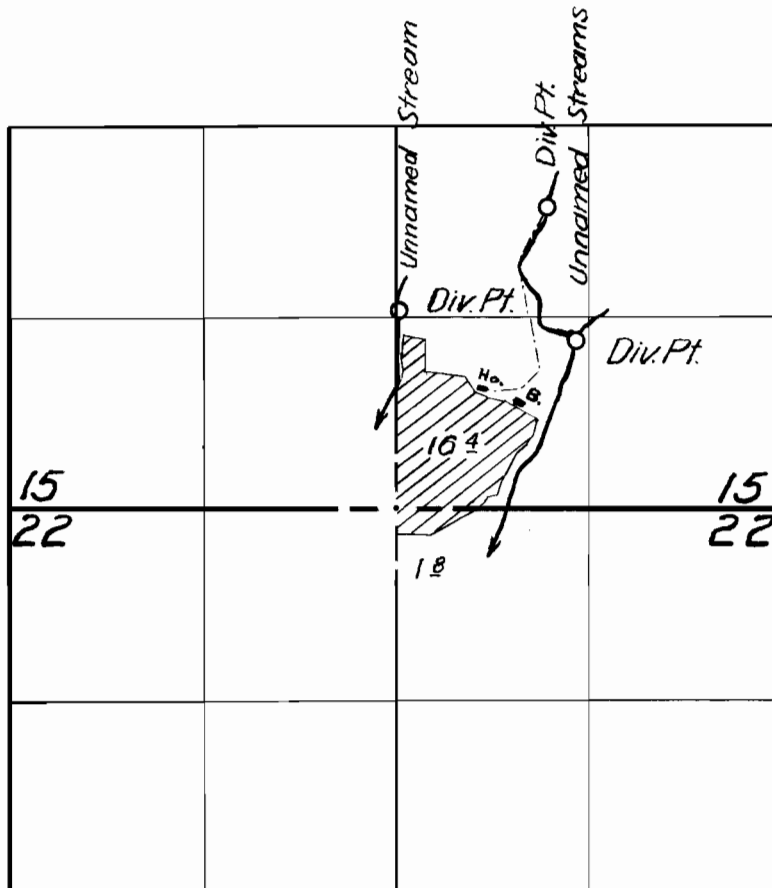

FINAL PROOF SURVEY
UNDER

Application No. 19038. Permit No. 14644.
IN NAME OF

MELVIN BOOK

Surveyed July 18 1955, by *M. Bish*