


T6S., R. 10 & 11 W. W. M.

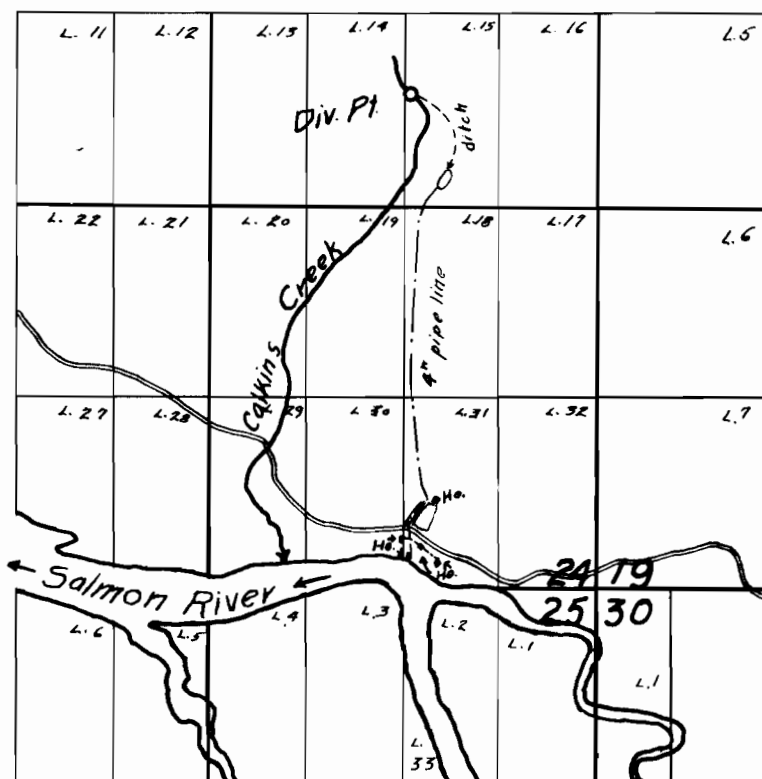

**FINAL PROOF SURVEY**  
UNDER

Application No. 19304 ... Permit No. 14890...  
IN NAME OF

**E. G. CALKINS**

Surveyed 25 August, 1955, by Robert Reed