


T. 3 N. R. 7 W. W. M.

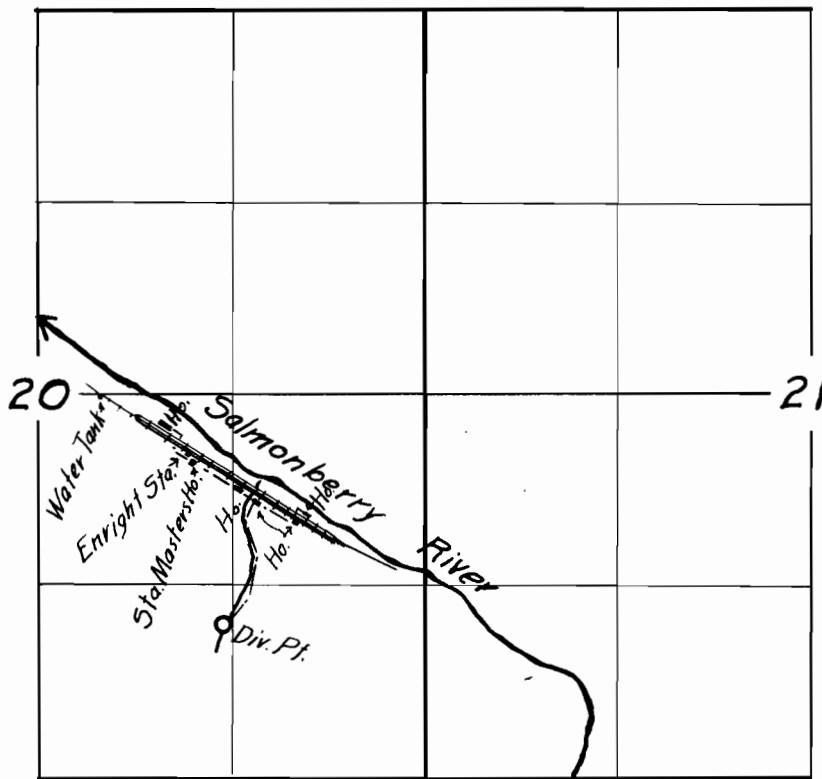

**FINAL PROOF SURVEY**

UNDER

Application No. 19505 ... Permit No. 15076 ...


IN NAME OF

**SOUTHERN PACIFIC COMPANY**

Surveyed 28 July ... 1955, by *Robert H. ...*

# ENRIGHT

Map to accompany application for permit to appropriate the waters of an unnamed creek tributary to Salmonberry River in the S.E 1/4 of Sec. 20, T.3N., R.7W., W.M. Tillamook County, Oregon, by the Southern Pacific Company.

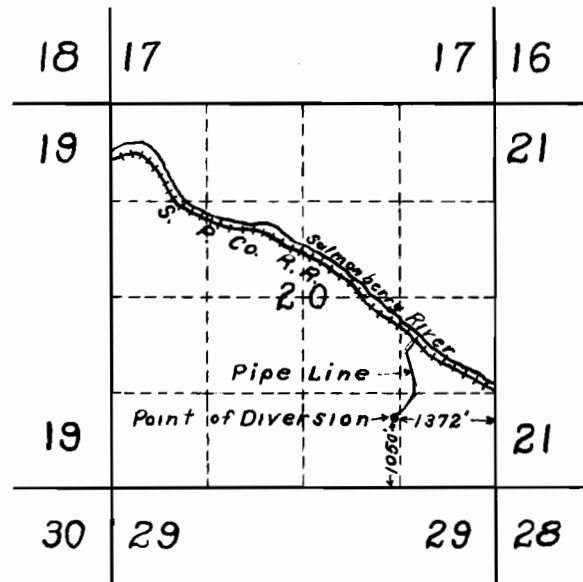

Scale 2" = 1 mi

Application No 14505-  
Permit No. 15076

I, G. Haselton, of Portland, Oregon, do hereby certify that this map was made from notes taken during an actual survey made under my supervision on Nov. 11, 1940 and that it correctly represents the works described in the accompanying application, together with the location of streams and ditches in the immediate vicinity

*G. Haselton*

Registered Engineer No. 140  
State of Oregon