


# T.1 S.R44E. W.M.

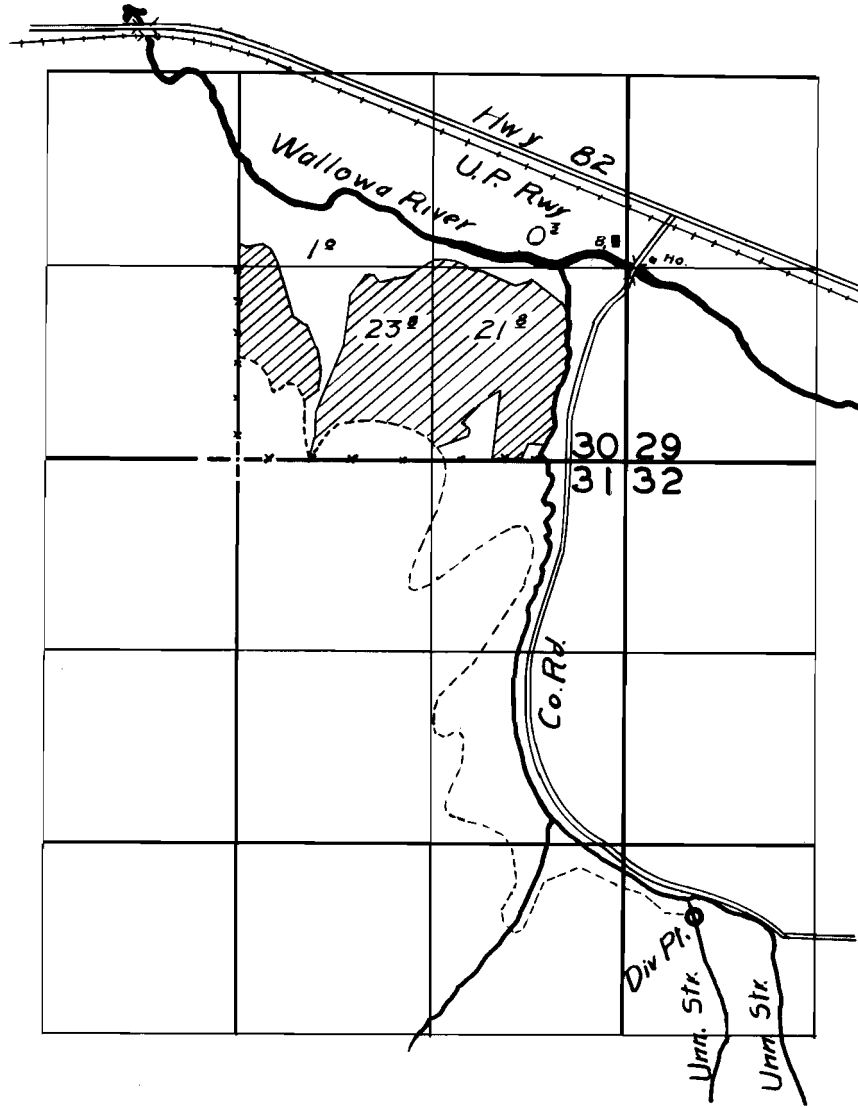

## FINAL PROOF SURVEY

UNDER

Application No. *20284*. Permit No. *15824*.

IN NAME OF

W. R. STEIN

Surveyed *14 August*, 1955, by *[Signature]*