


T. I. S. R. 9 W. W. M.

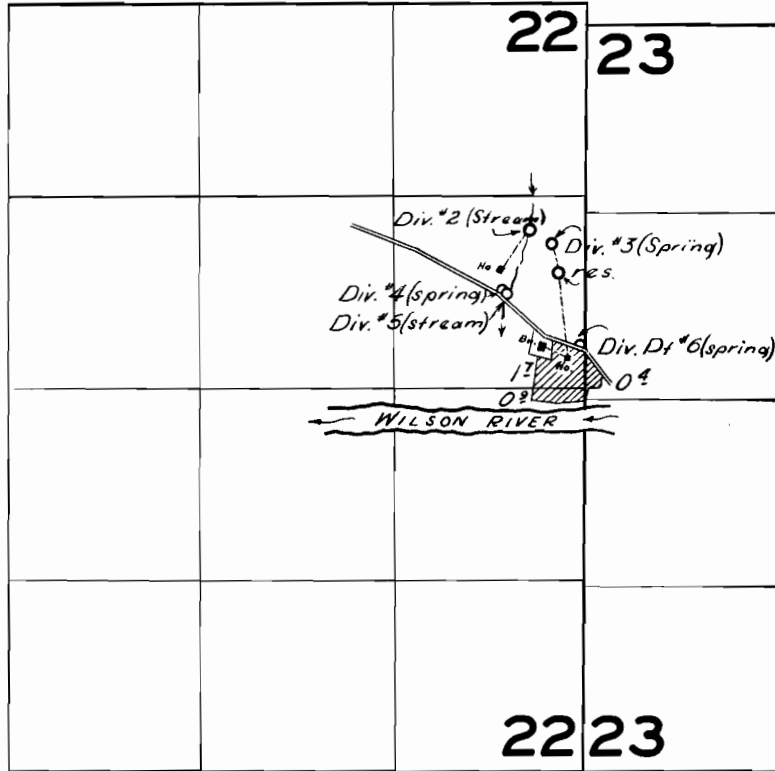

FINAL PROOF SURVEY UNDER

Application No. 20351... Permit No. 15874
IN NAME OF

LEO B. SANDER

Surveyed 10 Aug 1957, by *[Signature]*