


T.14 S. R.19E.W.M.

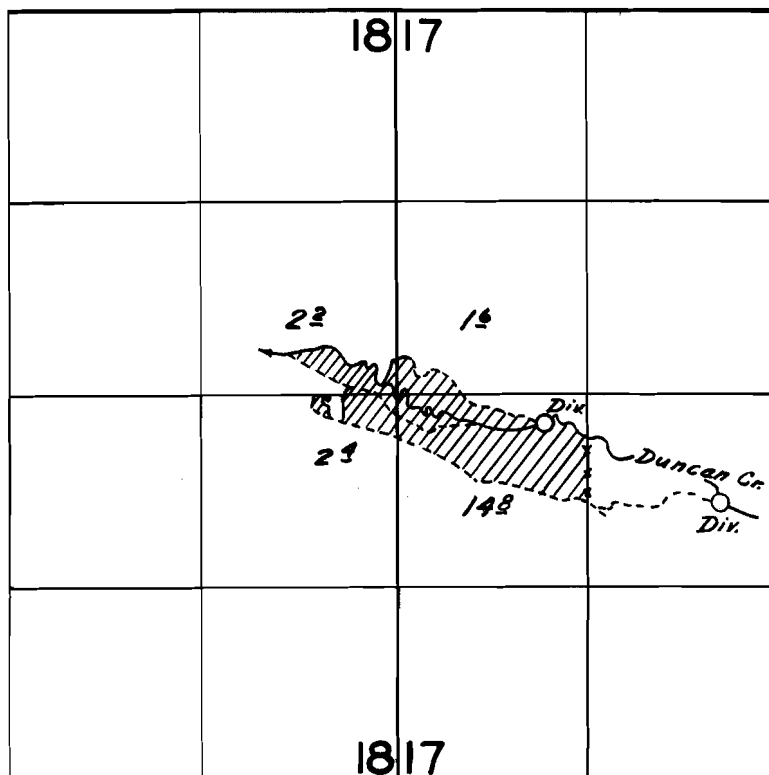

FINAL PROOF SURVEY
UNDER

Application No. *20386*... Permit No. *15899*...
IN NAME OF

E.A. McCORMICK

Surveyed *April 26, 1955*, by *T. Jones*...