


T.17S. R.21E.W.M.

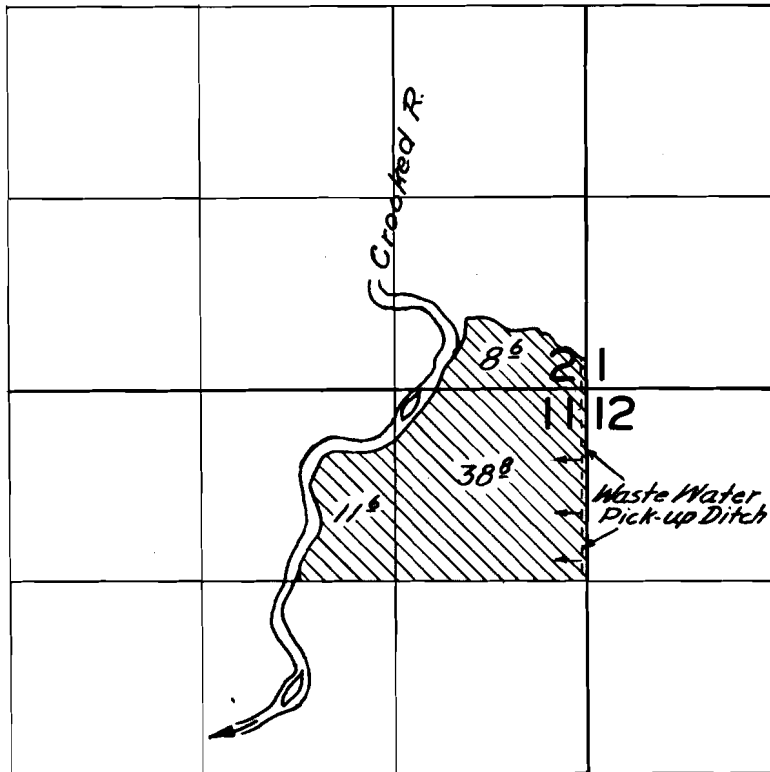

**FINAL PROOF SURVEY**

UNDER

Application No. 20631... Permit No. 16136...

IN NAME OF

GALE MERWIN

Surveyed April 25, 1955, by T. Jones.....