


16183

21726

T.40S.R.20E.W.M.

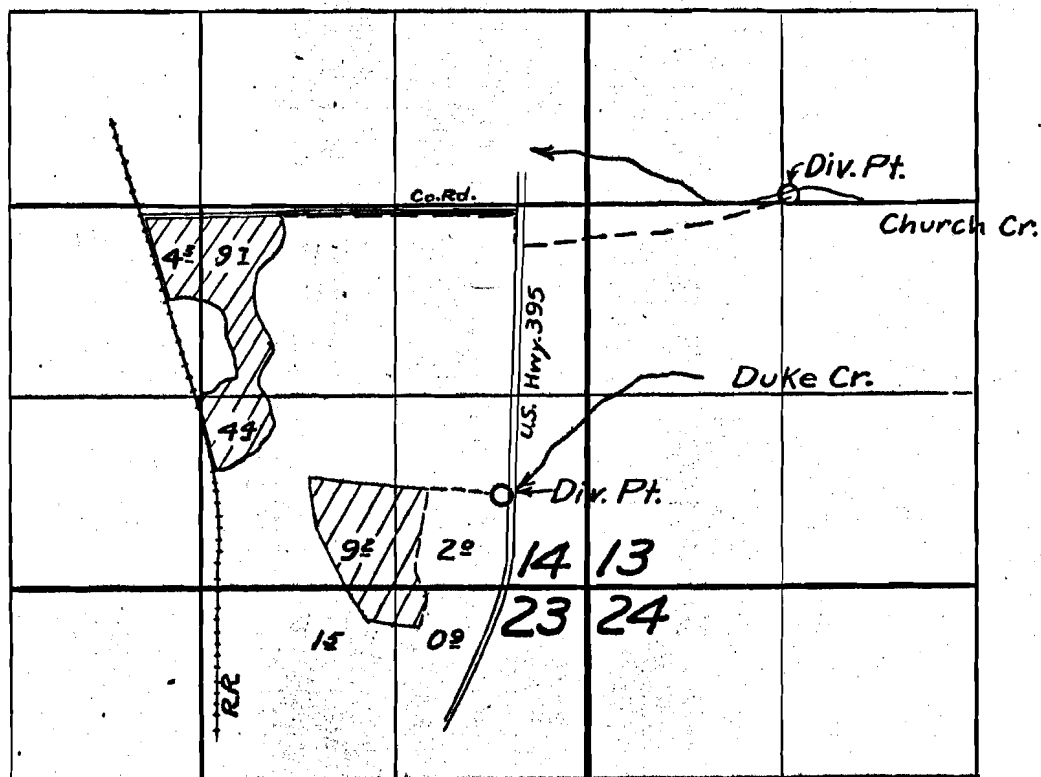

FINAL PROOF SURVEY UNDER

Application No. 20687 Permit No. 16183

IN NAME OF

James S. Snider & C.F. SniderSurveyed June 17, 1955, by T. Jones

40-20 ✓

CHZ-38K-178