


T.4N.R.25E.W.M.

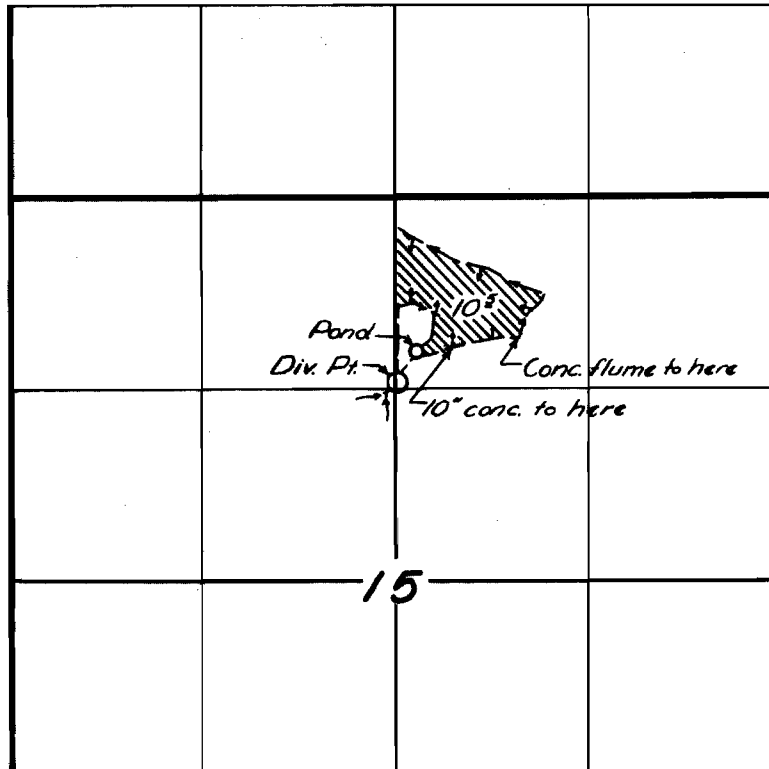

FINAL PROOF SURVEY

UNDER

Application No. 20698 Permit No. 16221

IN NAME OF

ADOLF SKOUBO

Surveyed 12 Apr. 1955, by T. Jones