


TISR9WWM

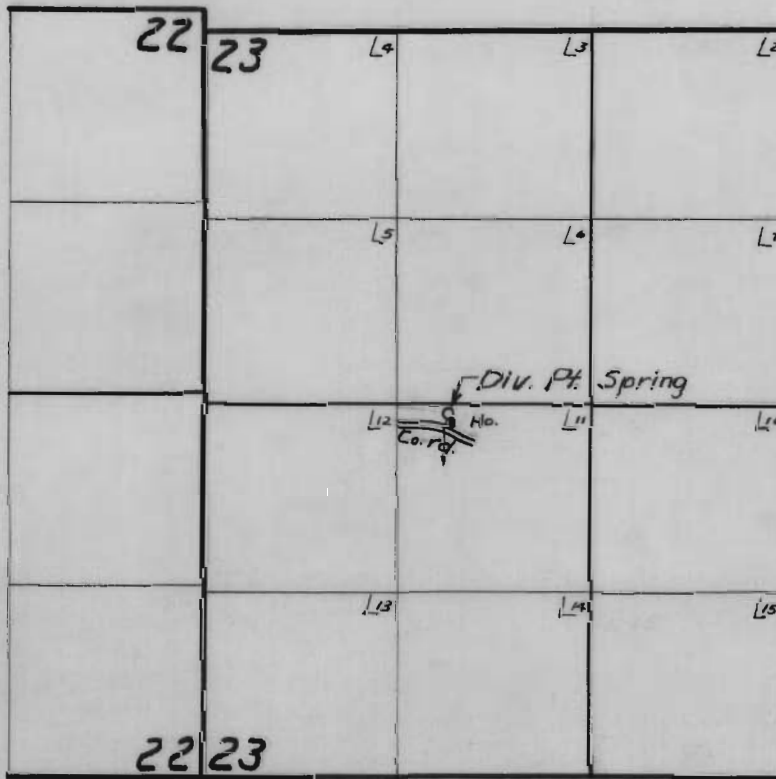

FINAL PROOF SURVEY
UNDER

Application No. 20784 Permit No. 16264

IN NAME OF

FRANK M. SANDER

Surveyed July 15 1955, by M. Bish