


DESCHUTES CO.

MI

Application No. 6108
Permit No. 3813

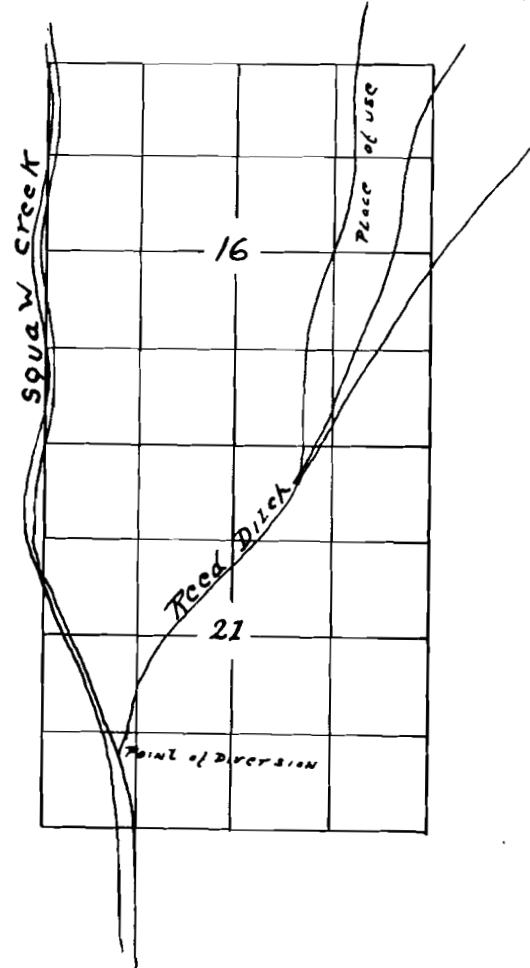

8012

8012