


36

TOWNSHIP 40 S, RANGE 14 W, W. M.

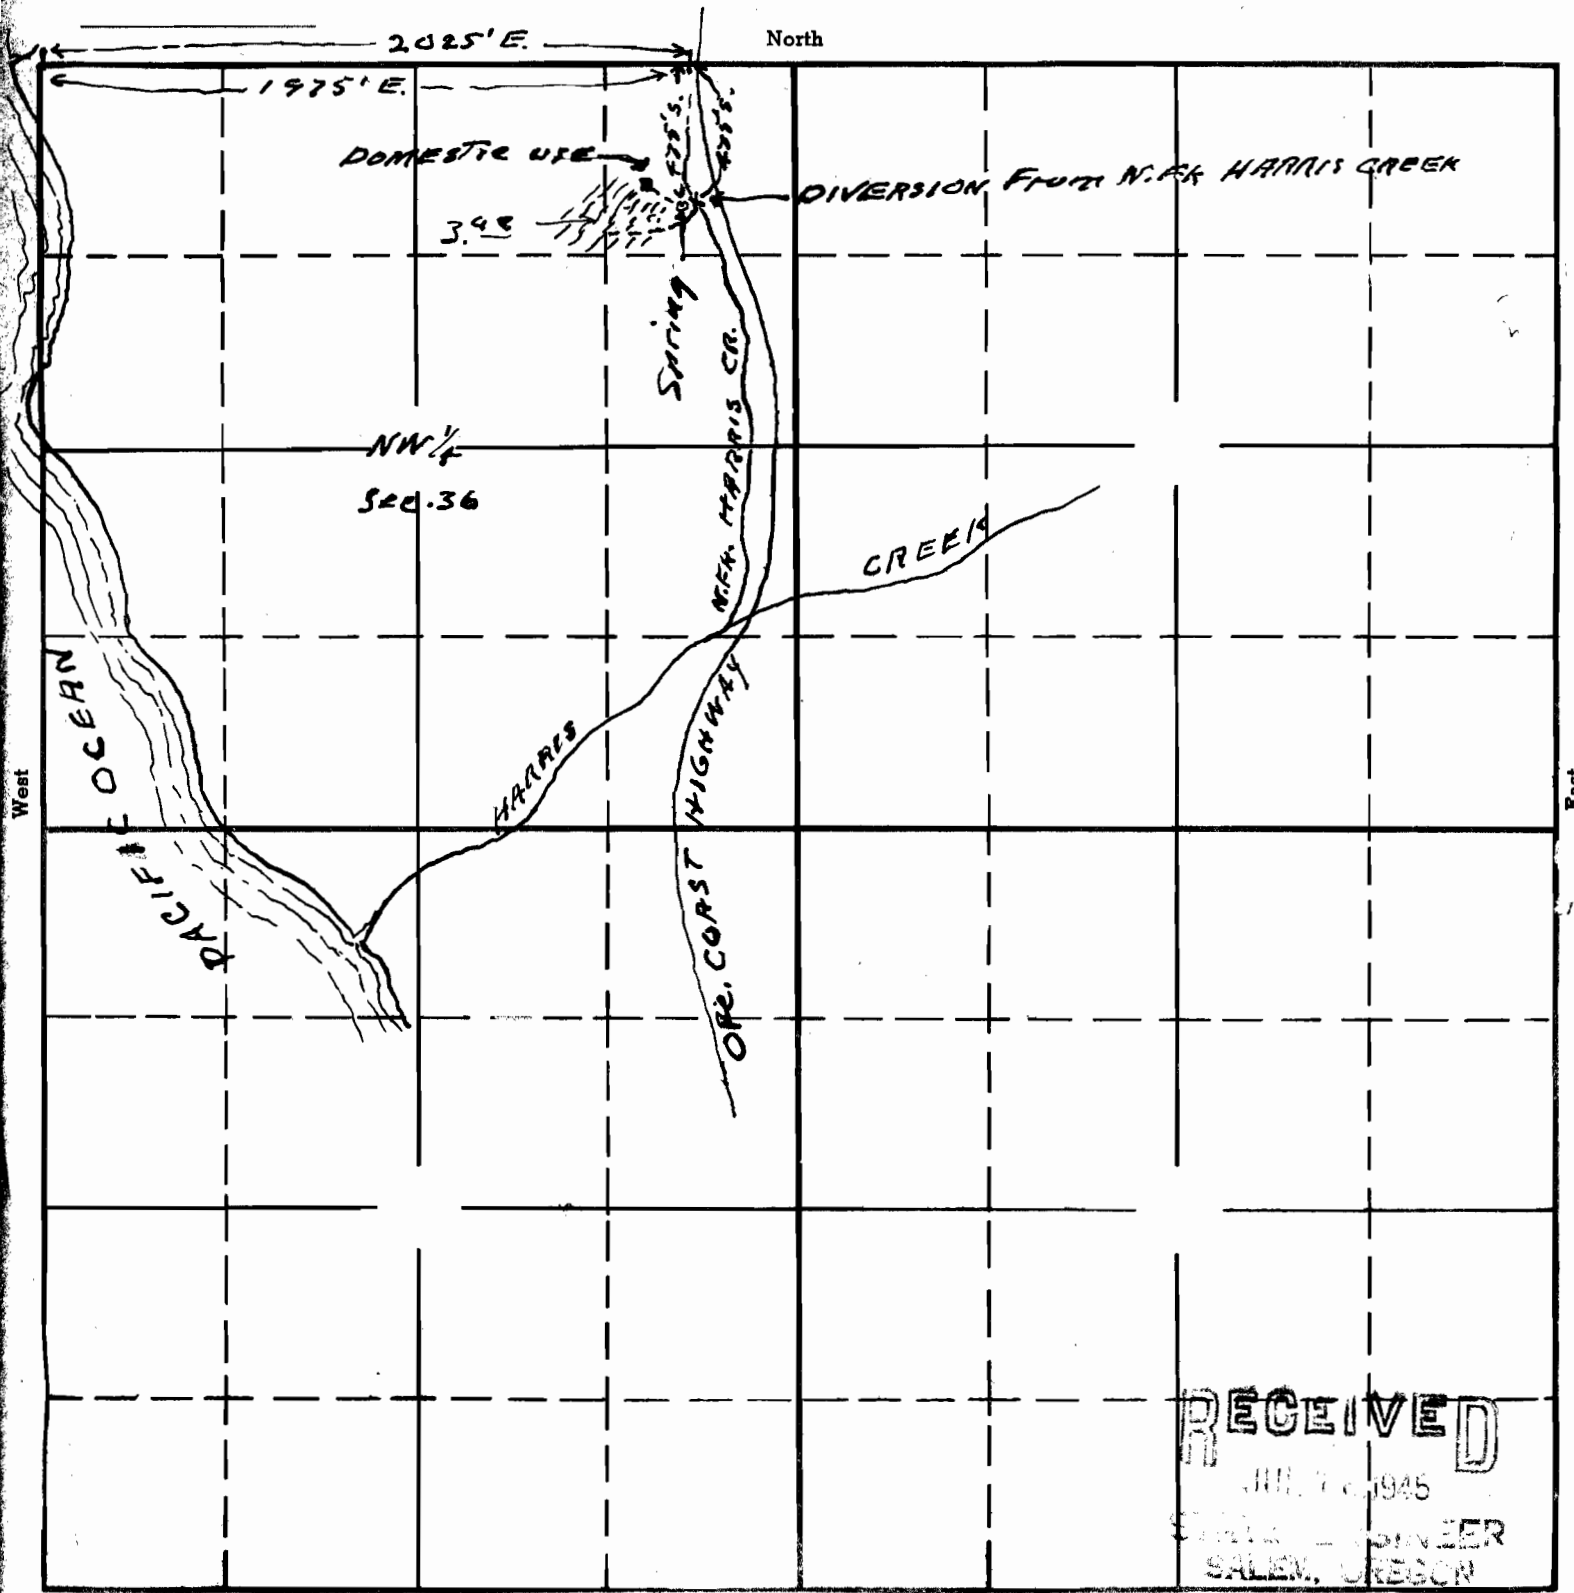

**RECEIVED**  
 JUL 7 1945  
 STATE ENGINEER  
 SALEM, OREGON

20970  
 15-23

APPLICATION No. 20970  
 PERMIT No. 16416

Map To accompany application of  
 George R & Viola H Moore for use of  
 water of N.F.K. Harris Creek for  
 irrigation and domestic purposes

This office 7/12/45 *[Signature]*