


T.20S.R.46 & 47E.W.M.

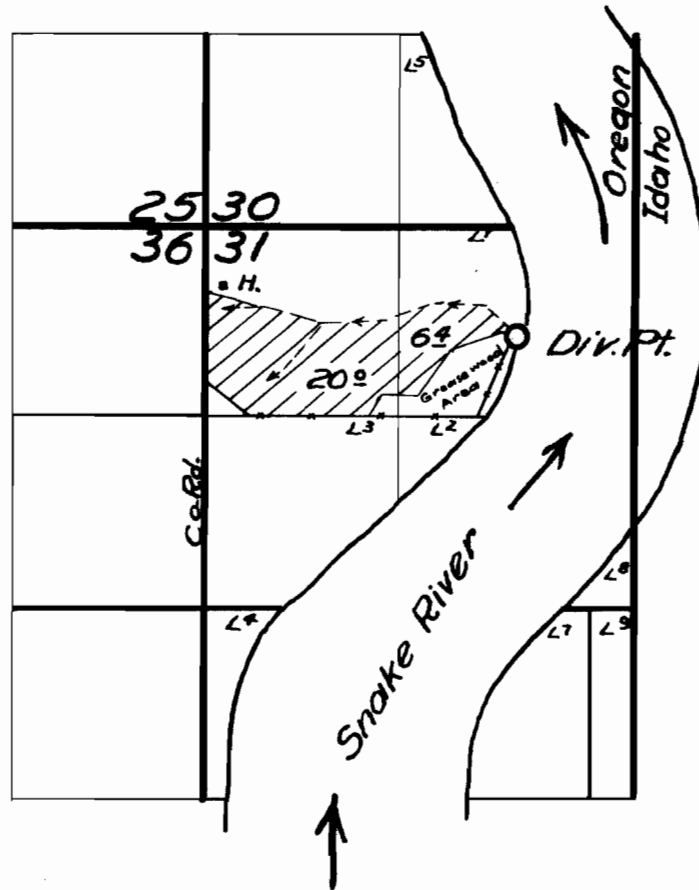

**FINAL PROOF SURVEY**  
UNDER

Application No. 21112 Permit No. 16542  
IN NAME OF

Clarence H. Cassel

Surveyed Oct. 15 1955, by M. Bish