


T.4S.R39E.W.M.

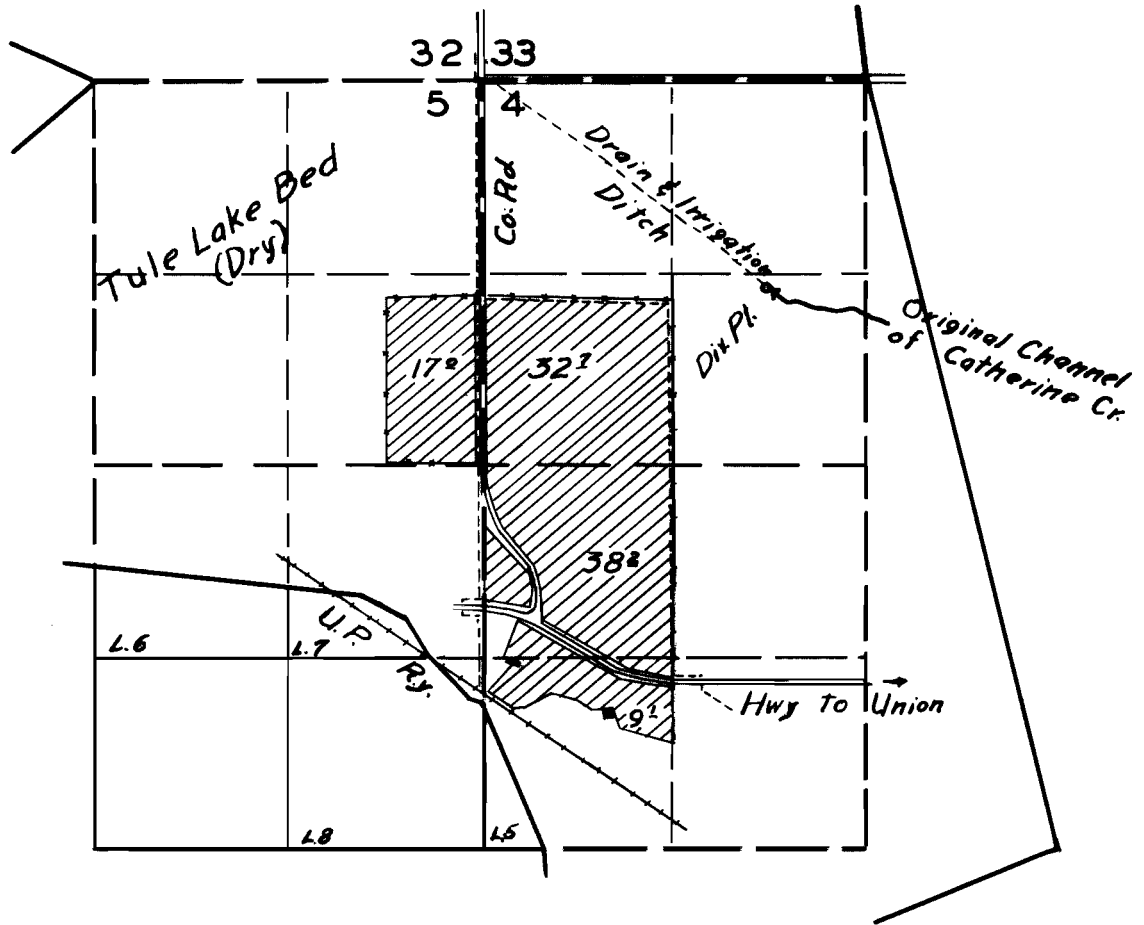

**FINAL PROOF SURVEY**

UNDER

Application No. 21348... Permit No. 16732...

IN NAME OF

BURR COURTRIGHT

Surveyed 12 August 1955, by Robert H. Burr