


T.28S.R.10W.W.M.

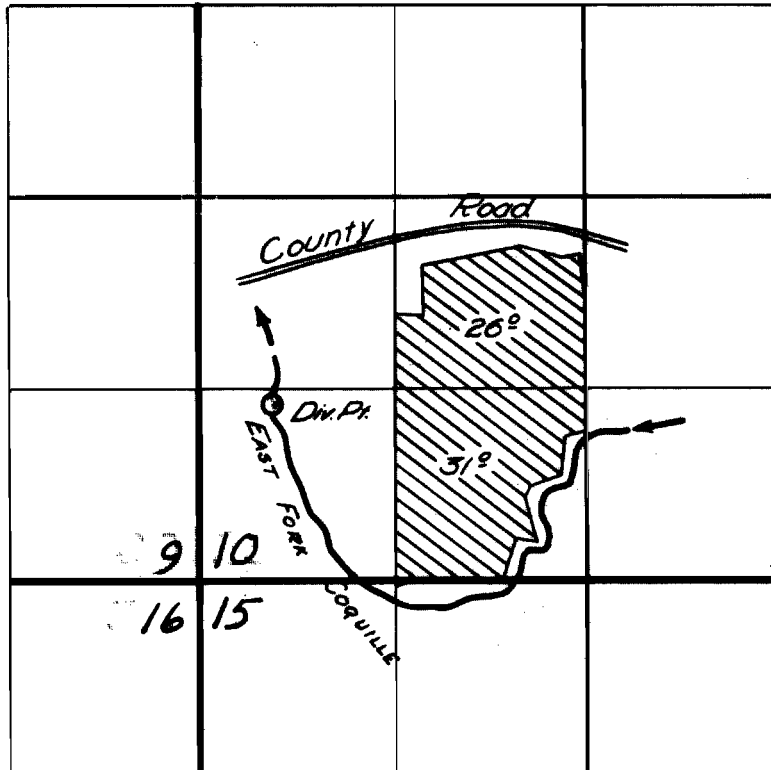

FINAL PROOF SURVEY

UNDER

Application No. 21358 Permit No. 16736

IN NAME OF

O. KENNETH LAIRD

Surveyed 19 Mar. 1955, by T. JONES

1955-Y