


T18SR46EWM

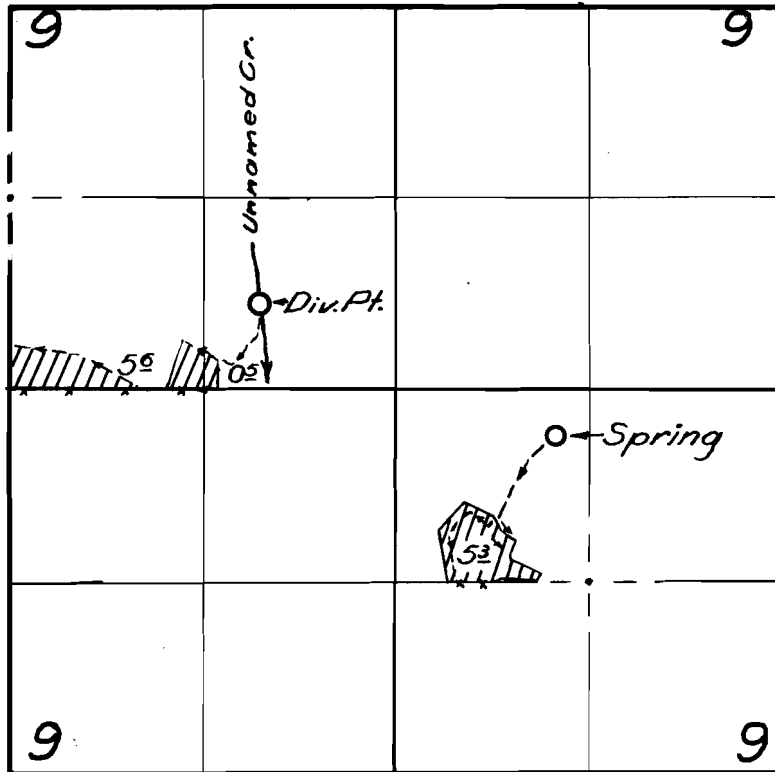

FINAL PROOF SURVEY

UNDER

Application No. 20153 Permit No. 16760

IN NAME OF

Lawrence P. Monce

Surveyed Oct. 9 1955, by M. Bish