


T. 27 S. R. 12 W. W.M.

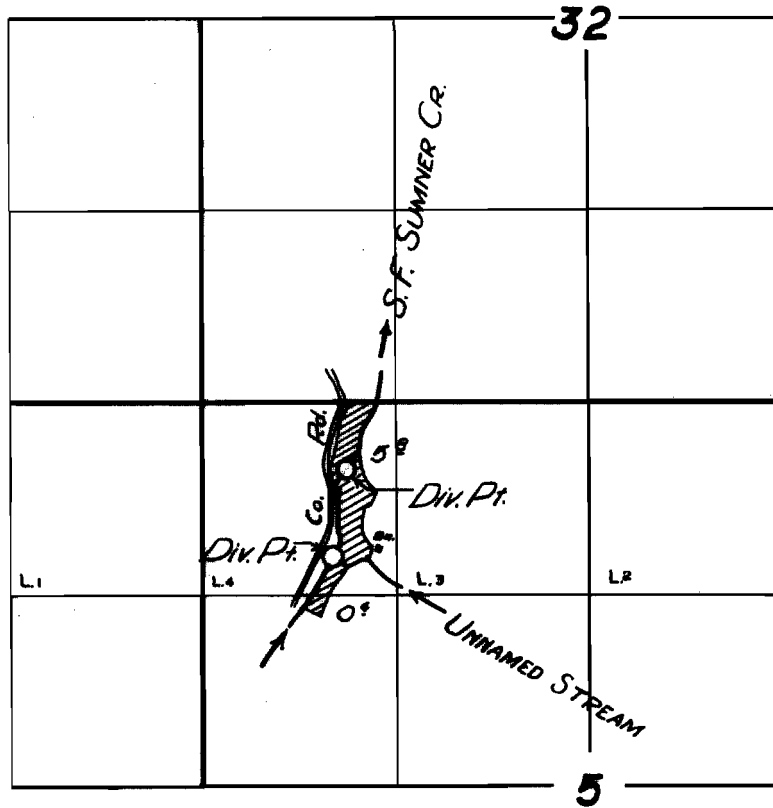

FINAL PROOF SURVEY
UNDER

Application No. 22176 Permit No. 17464
IN NAME OF

EARL J. KIRCHOFF

Surveyed 16 March 1955, by T. JONES