


T1&2SR9WWM

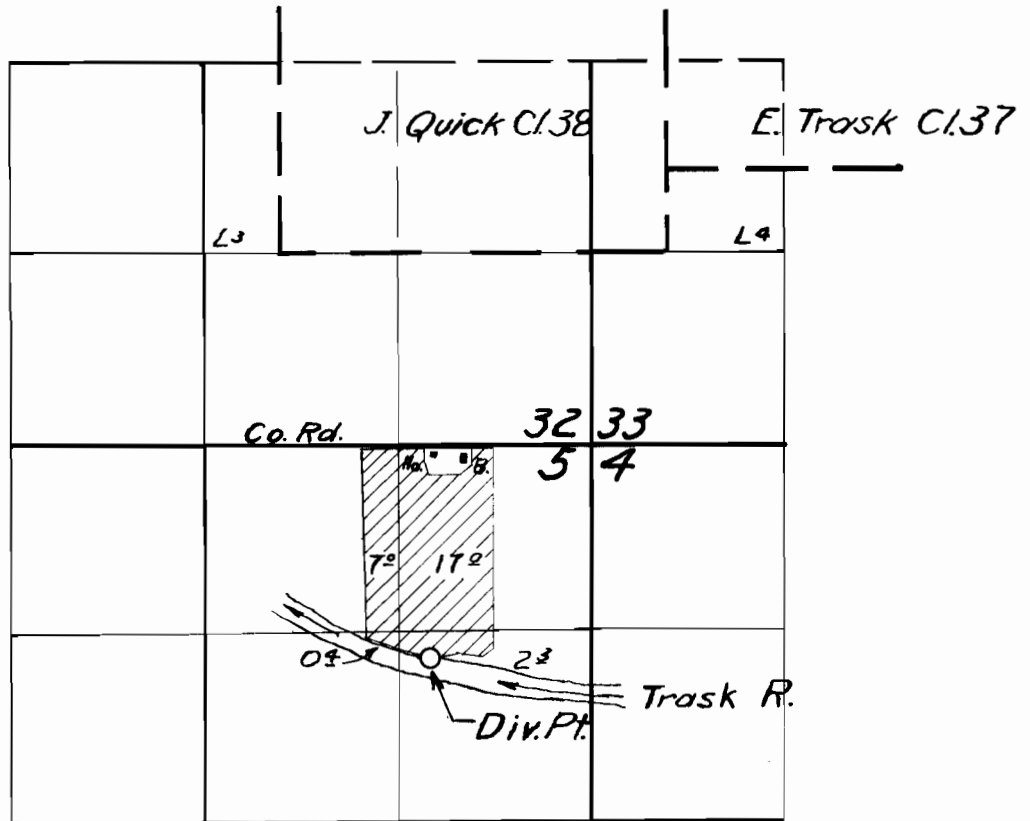

**FINAL PROOF SURVEY**

UNDER

Application No. 23953 Permit No. 18908

IN NAME OF

ADOLF LEWTHOLD

Surveyed July 22 1955, by m. Beh