


T. 1 S., R. 39 E. W.M.

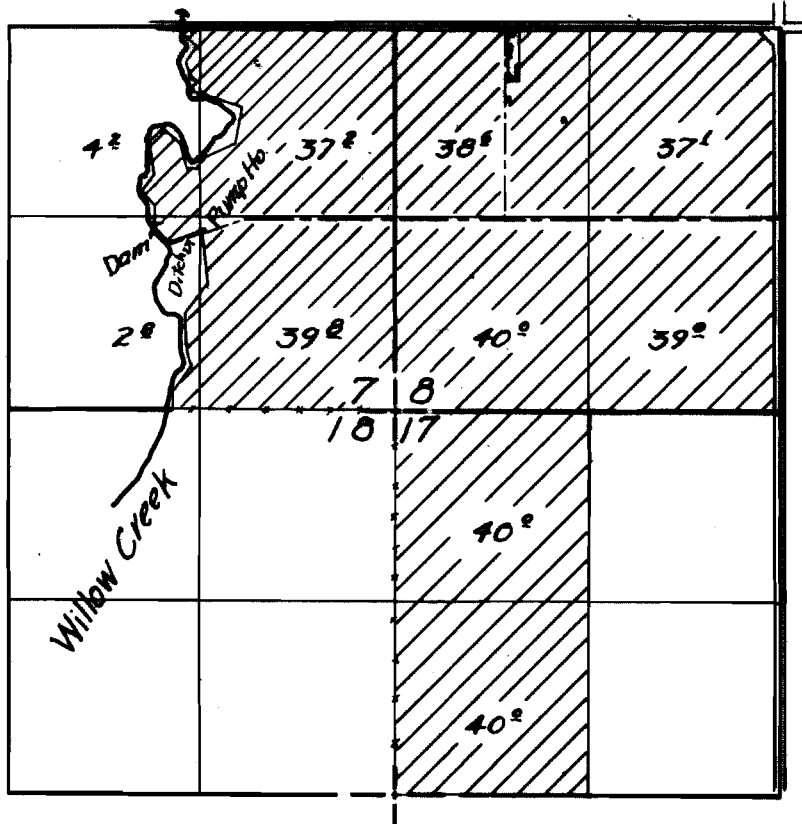

FINAL PROOF SURVEY

UNDER

Application No. 23962 Permit No. 18913

IN NAME OF

GEORGE & ELIZABETH ROYES

Surveyed 23 October 1955, by Robert A. [Signature]