


T.4S.R.10W.W.M.

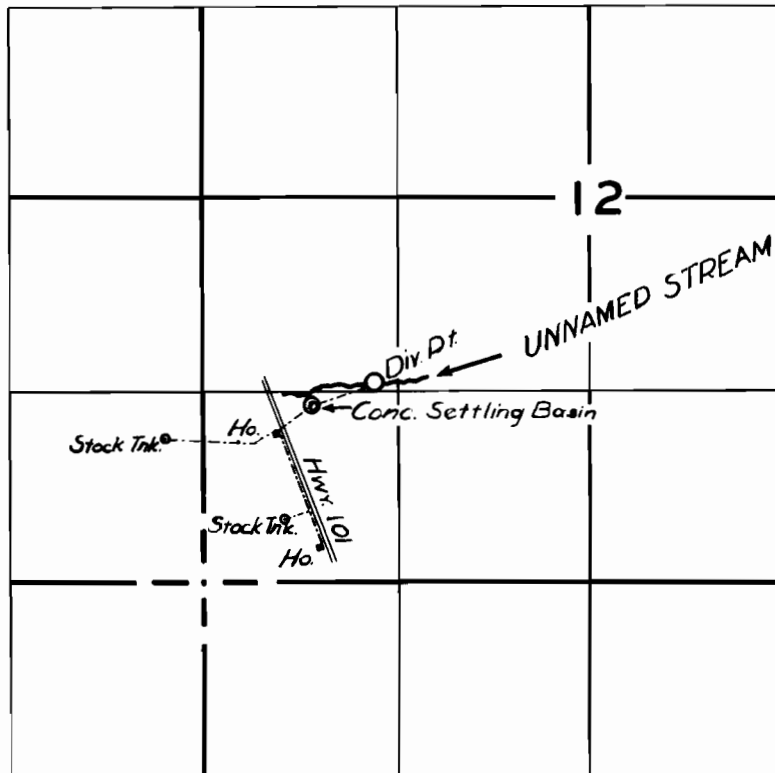

FINAL PROOF SURVEY

UNDER

Application No. 24005 Permit No. 18933

IN NAME OF

**DELMAR & MARIE SHULTZ
WALTER & CAROLINE BAUMGARTNER**

Surveyed 25 Aug 1955, by *R. P. Whiteby*