


T28SR12&13WWM

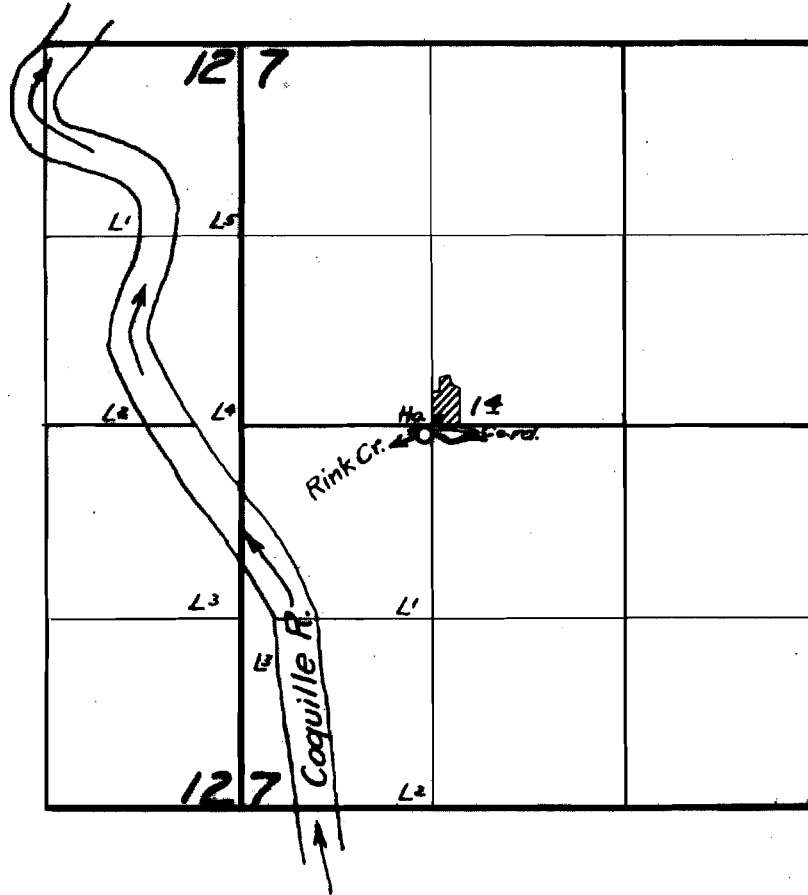

FINAL PROOF SURVEY

UNDER

Application No. 24097 Permit No. 18951

IN NAME OF

WALTER A. MOORE

Surveyed Aug. 5 1955, by M. A. Bush