


T. 4.S.R. 9W.W.M.

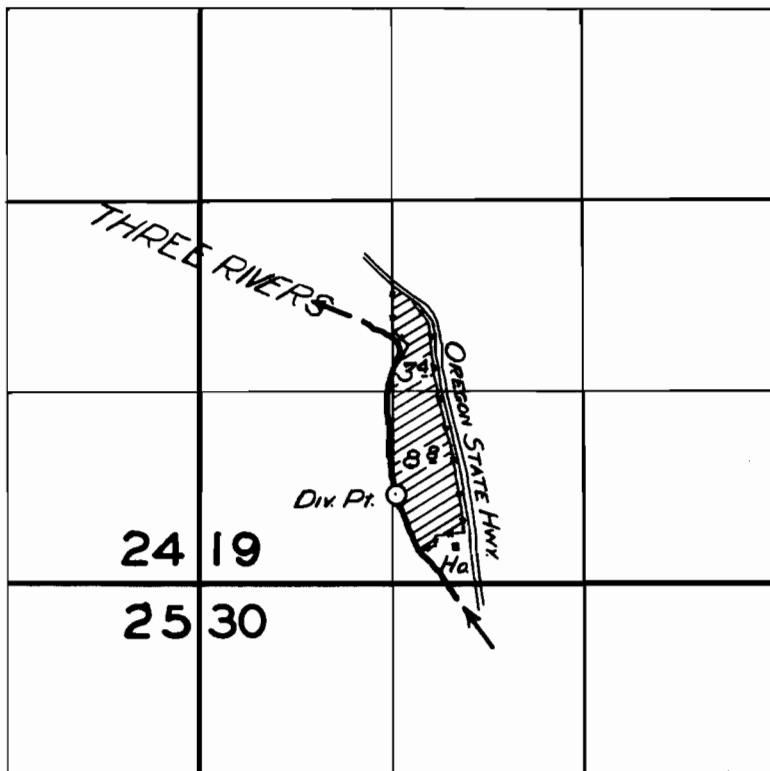

**FINAL PROOF SURVEY**

UNDER

Application No. 23889 Permit No. 19072

IN NAME OF

**ROBERT O. & DOROTHY BAKER**

Surveyed 1 Sep 1955, by R. A. Whitley