


T.14 S. R.19 E.W.M.

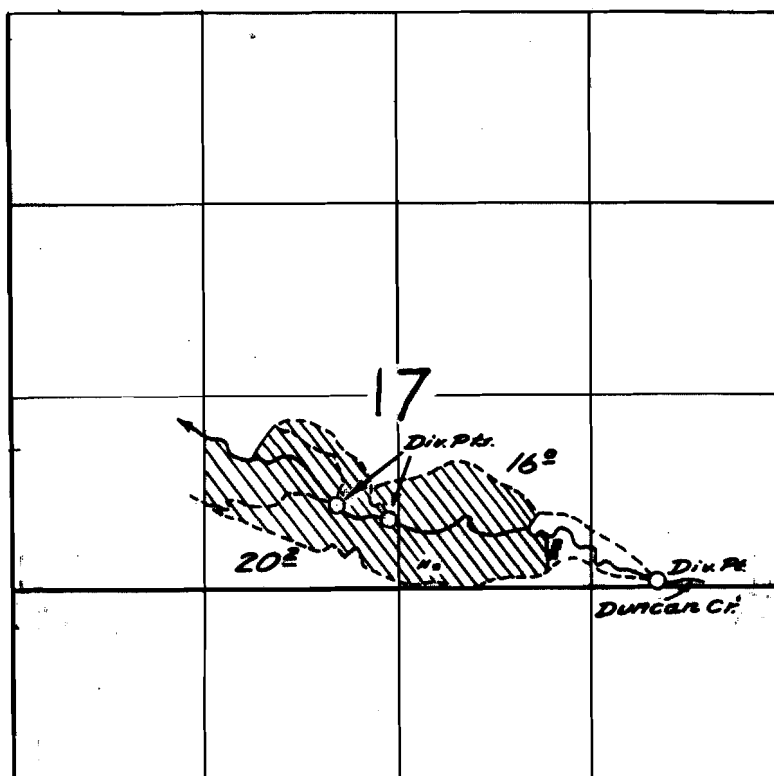

FINAL PROOF SURVEY
UNDER

Application No. 24385 Permit No. 19146
IN NAME OF

William H. Tackman

Surveyed April 26 1955, by T. Jones