


T27&28SR11WWM

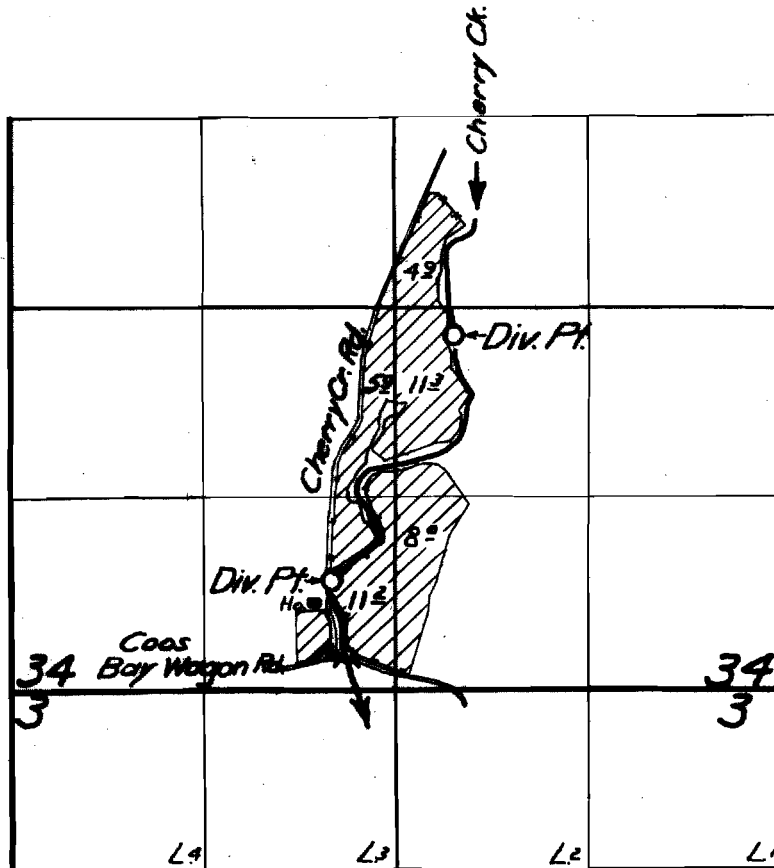

**FINAL PROOF SURVEY**  
UNDER

Application No. 24390 Permit No. 19147  
IN NAME OF

BEN HUDSON

Surveyed Aug 31 1955, by M. Bish