


T.15., R. 38 & 39 E.W.M.

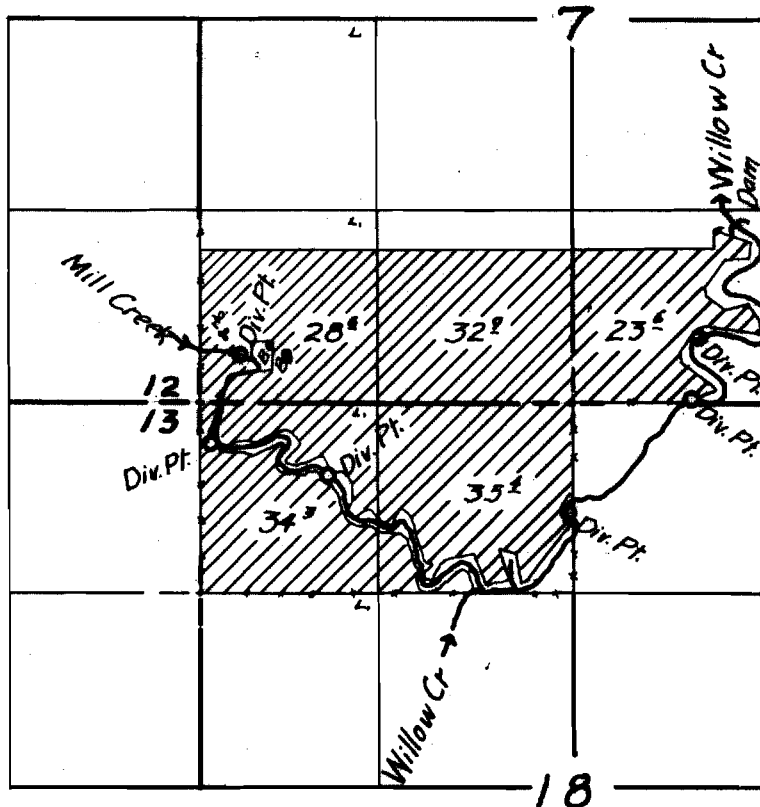

### FINAL PROOF SURVEY

UNDER

Application No. 24169... Permit No. 19202...

IN NAME OF

MYRON G. HUG

Surveyed 29 October 1955, by *Robert H. ...*