


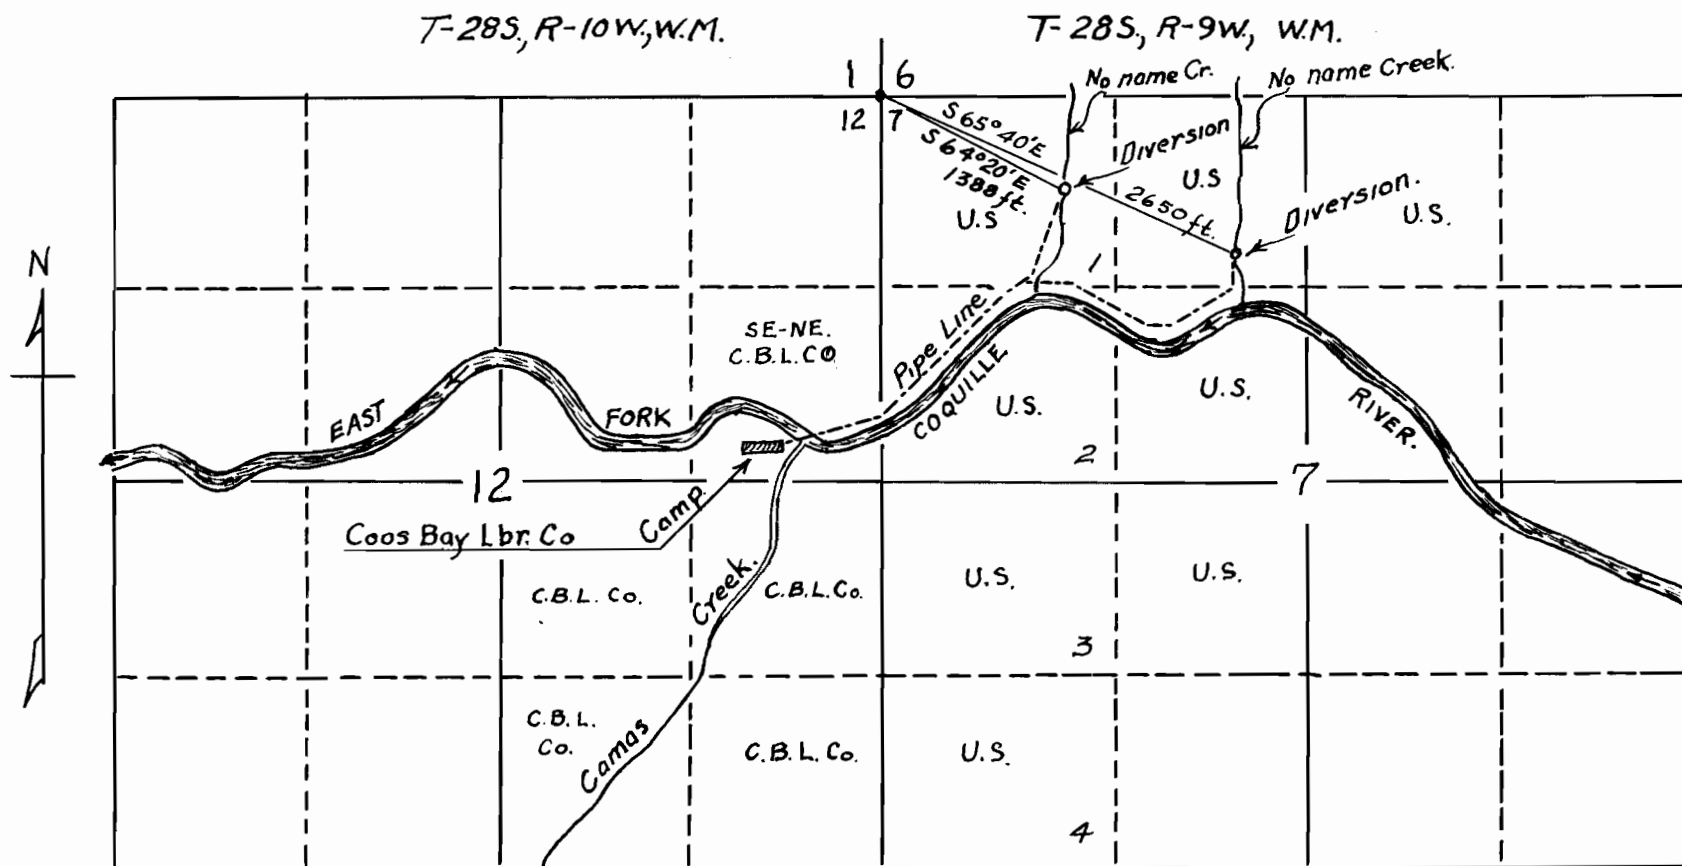

I, C.S. Lehmanowsky of Myrtle Point, Oregon do hereby
 certify that this map was made from notes taken during an
 actual survey made by me on March 20, 21, 1950, that the
 monuments shown on this map consisting of 1 in. Iron pipes.
 1st monument S 64° 20' E, 1,388 ft. from the N.W. Corner of Section 7, T-28 S., R-9W. W.M.
 2nd monument S 65° 40' E, 2,650 ft. from the N.W. Corner of Section 7, T-28 S., R-9W. W.M.

C.S. Lehmanowsky.

Application No. 24555
 Permit No. 19319