


TISRLOW.W.M.

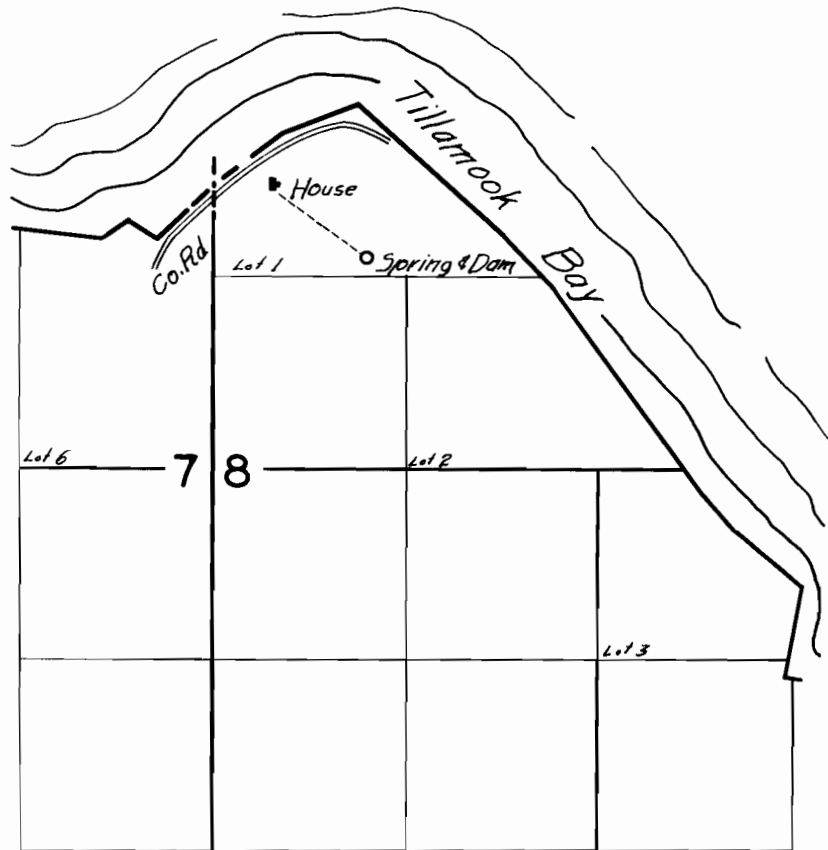

FINAL PROOF SURVEY

UNDER

Application No. 24573 . Permit No. 19370.

IN NAME OF

CARL B. HANSARD

Surveyed 19 July . 1955, by *Robert H. Beck*