


T.1N.,R.42E.W.M.

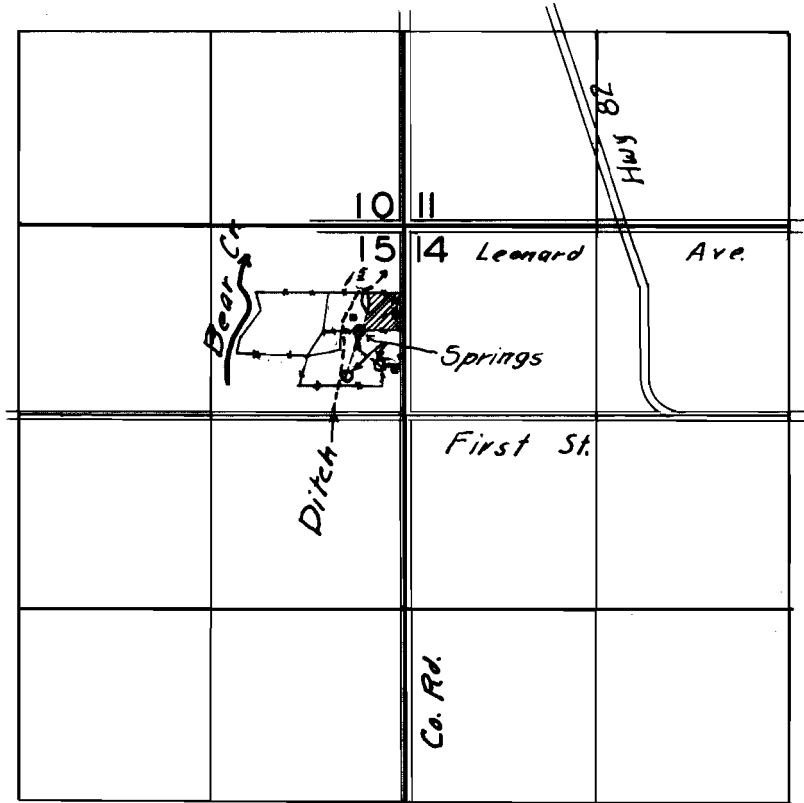

FINAL PROOF SURVEY

UNDER

Application No. 24632 Permit No. 19392

IN NAME OF

M. E. & CHRISTINA I. WAELTY

Surveyed 15 August 1955, by Robert H. Reut