


T. 3 & 4 S., R. 2 W. W.M.

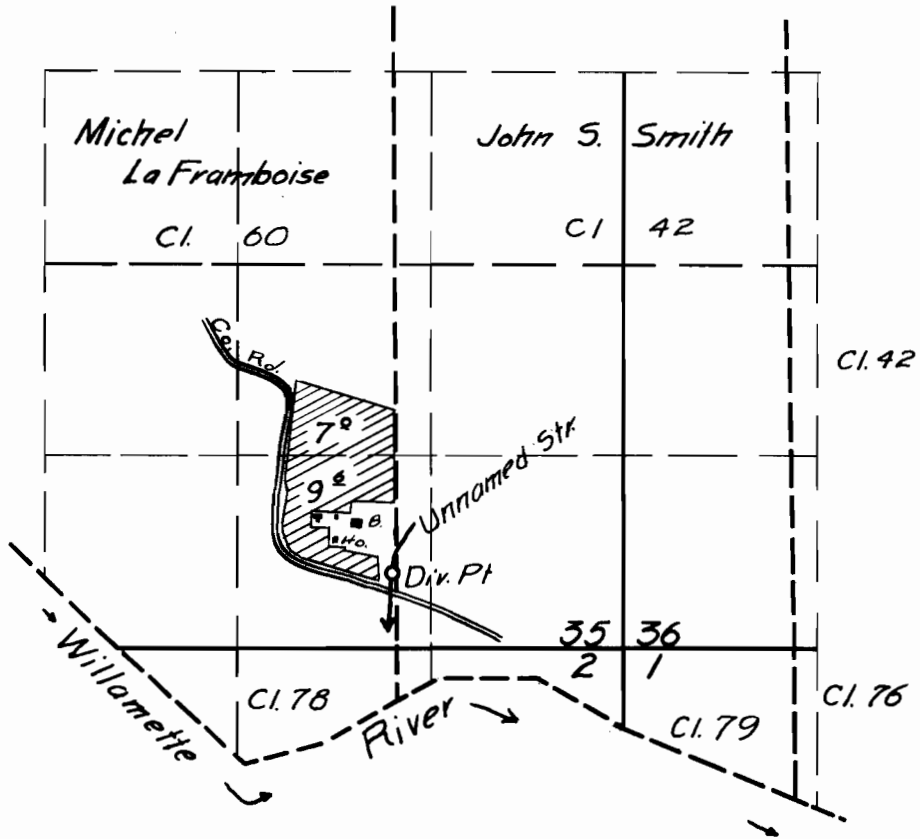

**FINAL PROOF SURVEY**

UNDER

Application No. 24553 Permit No. 19463  
IN NAME OF

T. H. MILLER

Surveyed 20 September 1955, by Robert H. [Signature]