


T. 27 S. R. 11 W. W.M.

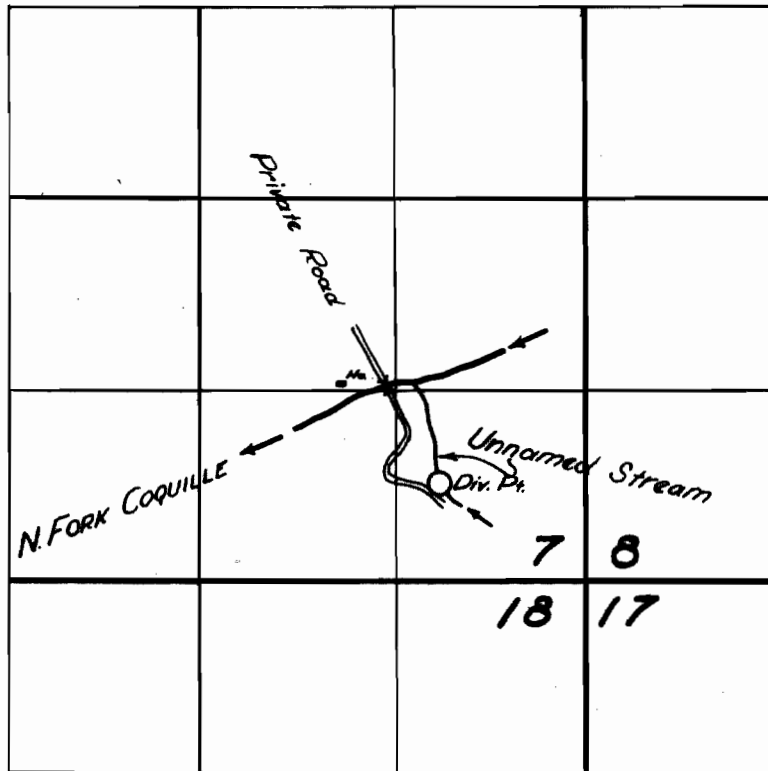

FINAL PROOF SURVEY

UNDER

Application No. 24667 Permit No. 19479

IN NAME OF

GLENN MAST

Surveyed 13 March 1955, by T. Jones

1955-Z1