


T. 4 N. R. 24 & 25 E. W. M.

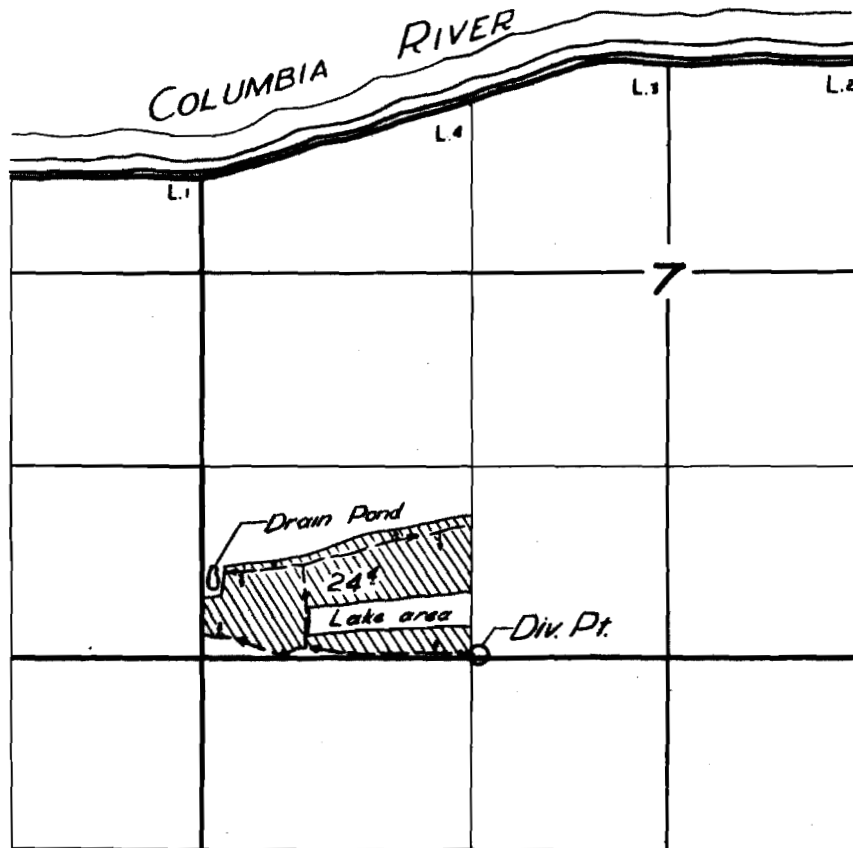

**FINAL PROOF SURVEY**  
UNDER

Application No. 24688 Permit No. 19487  
IN NAME OF

CHARLES A. ANDEREGG

Surveyed 12 Apr. 1955, by T. JONES