


19548
21765
21830

T. 2 S. R. 25 E. W. M.

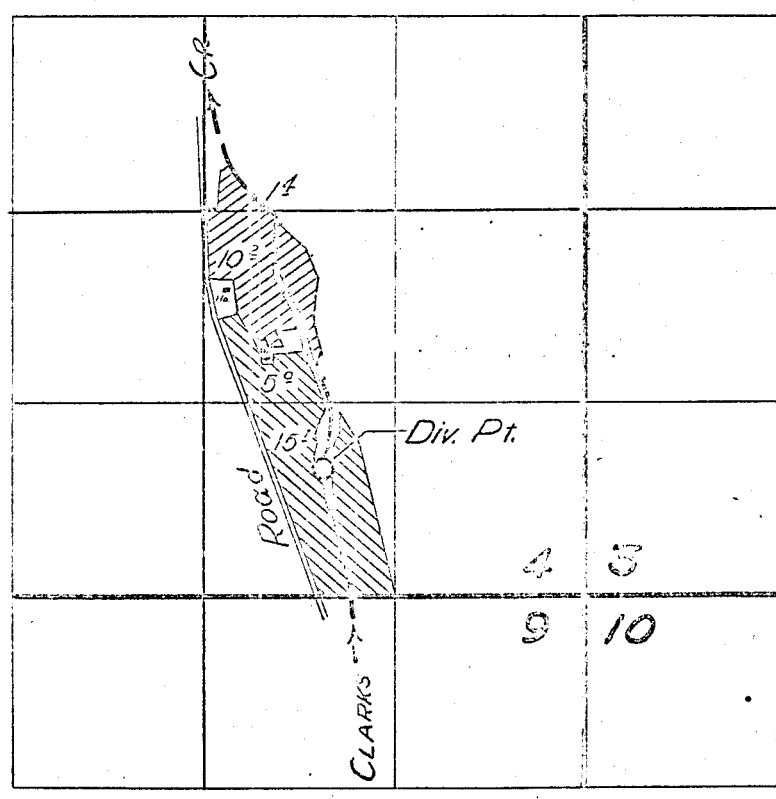

FINAL PROOF SURVEY

UNDER

24825

19548

Application No. 28172

Permit No. 22170

IN NAME OF

EMMA P. PECK

Surveyed 15 Apr. 1955, by T. JONES

1955-Z