


T29SR12WWM

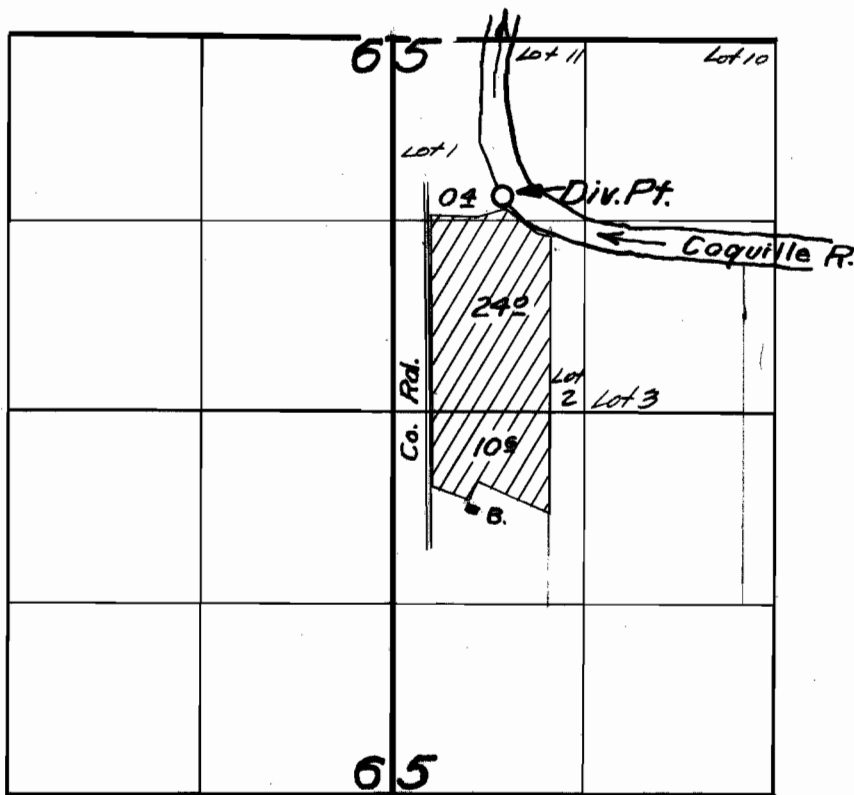

**FINAL PROOF SURVEY**

UNDER

Application No. 24993 Permit No. 19615

IN NAME OF

ALTON R. McCUE

Surveyed Aug 9 1955, by M. Bish