


T.3 N. R.9 & 10 W.W.M.

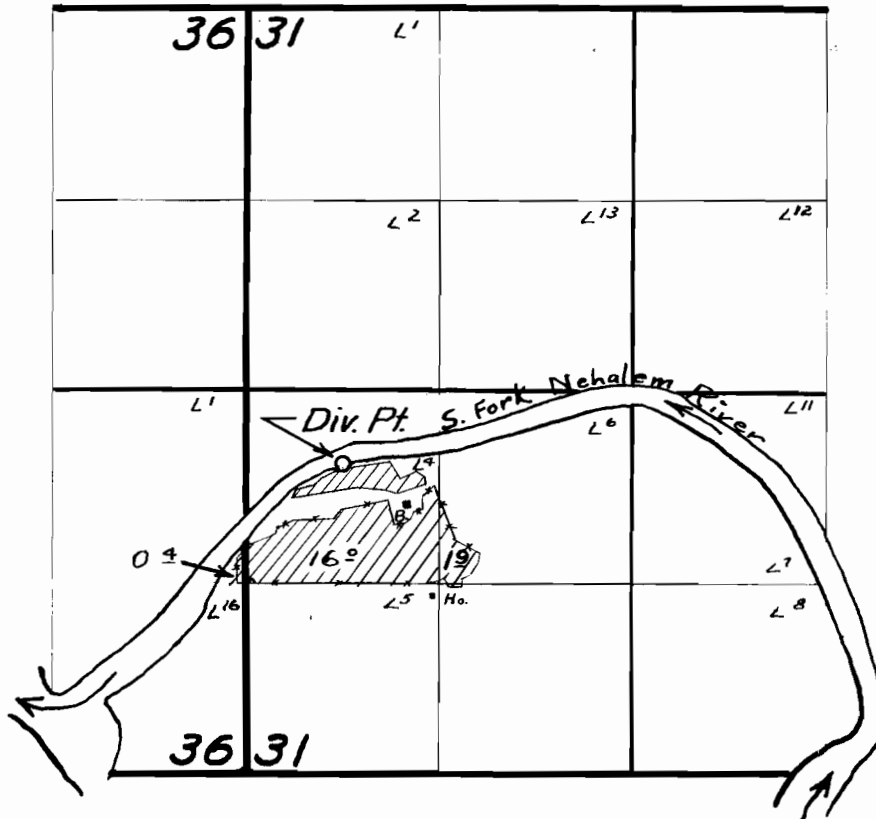

FINAL PROOF SURVEY
UNDER

Application No. 25159 Permit No. 19789
IN NAME OF

Stanley Lamb, M.D.

Surveyed Sept 21 1955 by *M. Sisk*