


T3NR10WWM

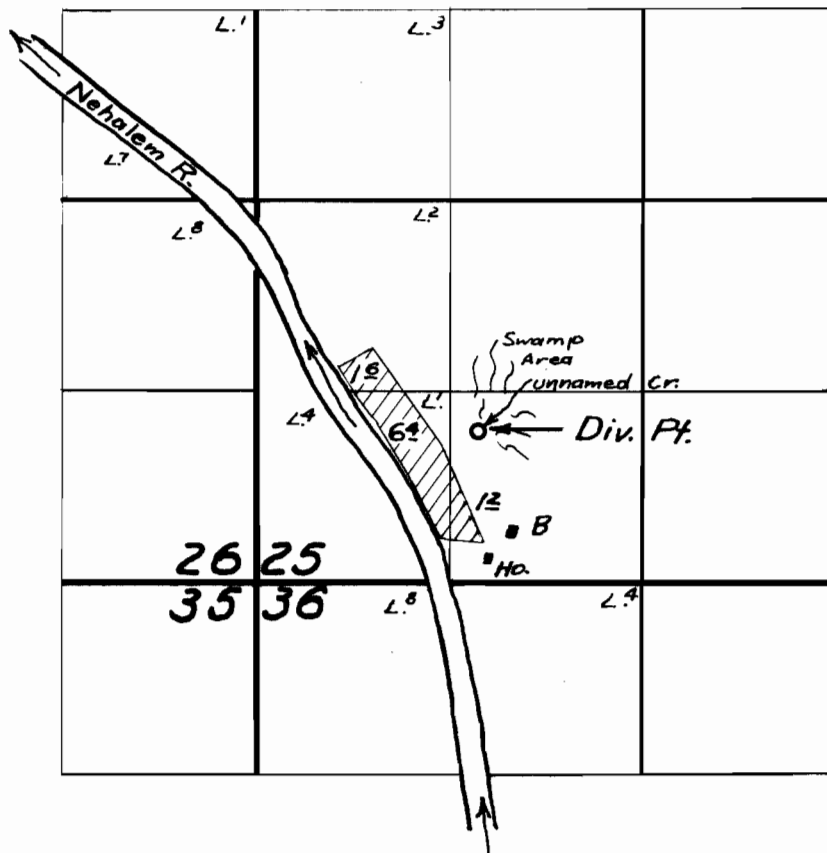

FINAL PROOF SURVEY

UNDER

Application No. 25173 Permit No. 19795

IN NAME OF

Agnes Z. Stephens

Surveyed Sept. 20 1955, by Tr. Bish

1955N