


T.2S. R.9W. WM

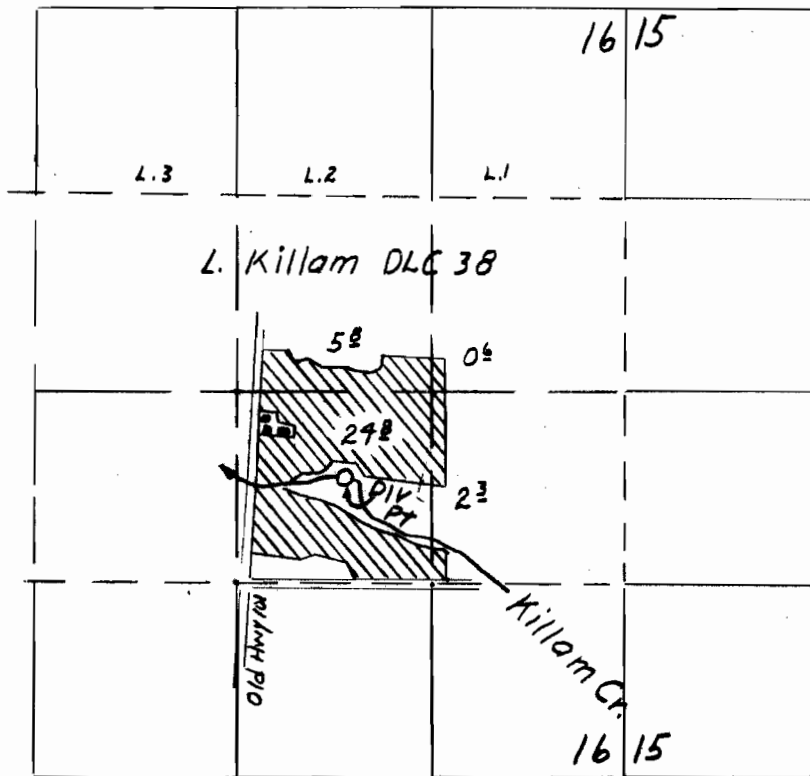

FINAL PROOF SURVEY

Under

Application 25261 Permit 19844

In name of

Harold Fogg

Surveyed Sept. 12, 1956 by R.H. Whitby