


# TIS. R 10 & I W. W. M.

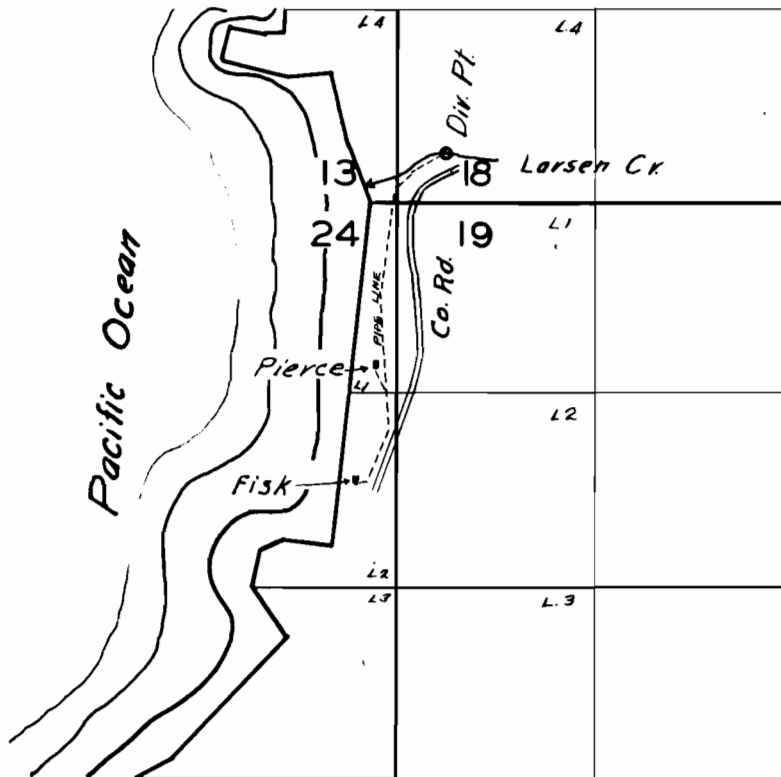

## FINAL PROOF SURVEY

UNDER

Application No. 25279 . Permit No. 19851 . . .

IN NAME OF

J. H. ROSENBERG

Surveyed 19 July . . . 1955, by *Robert H. Best*