


T2 #35R9 #10WWM

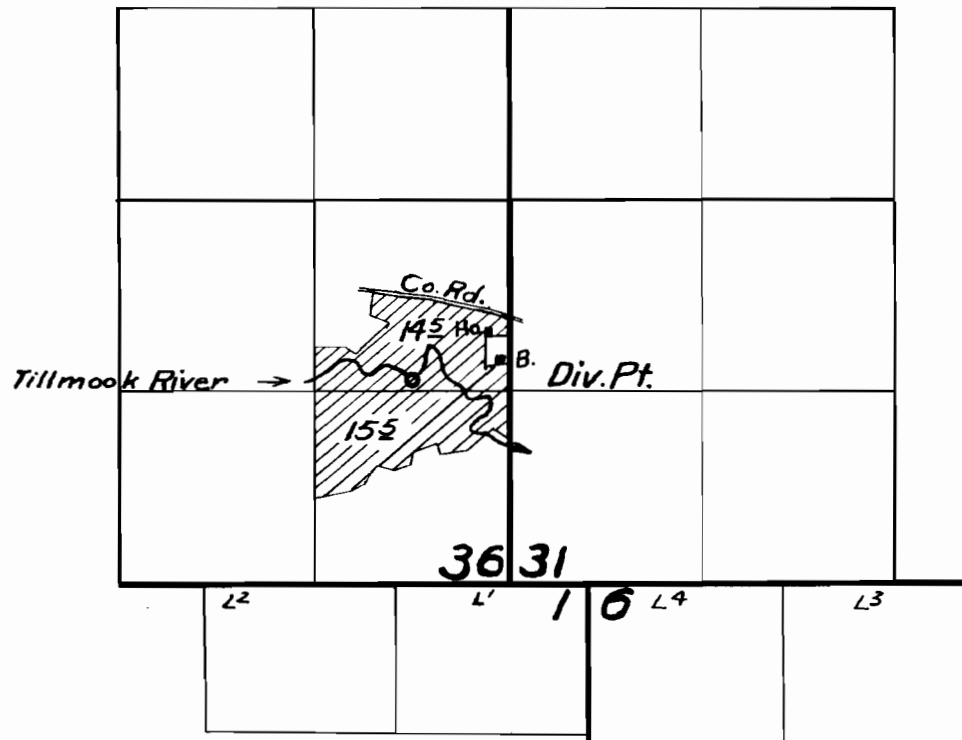

FINAL PROOF SURVEY

UNDER

Application No. 24827. Permit No. 19932.

IN NAME OF

HAROLD HERR

Surveyed Sept. 6 & 7 1955, by M. Bish

1955M