


T. 4 S. R. 4 W. W.M.

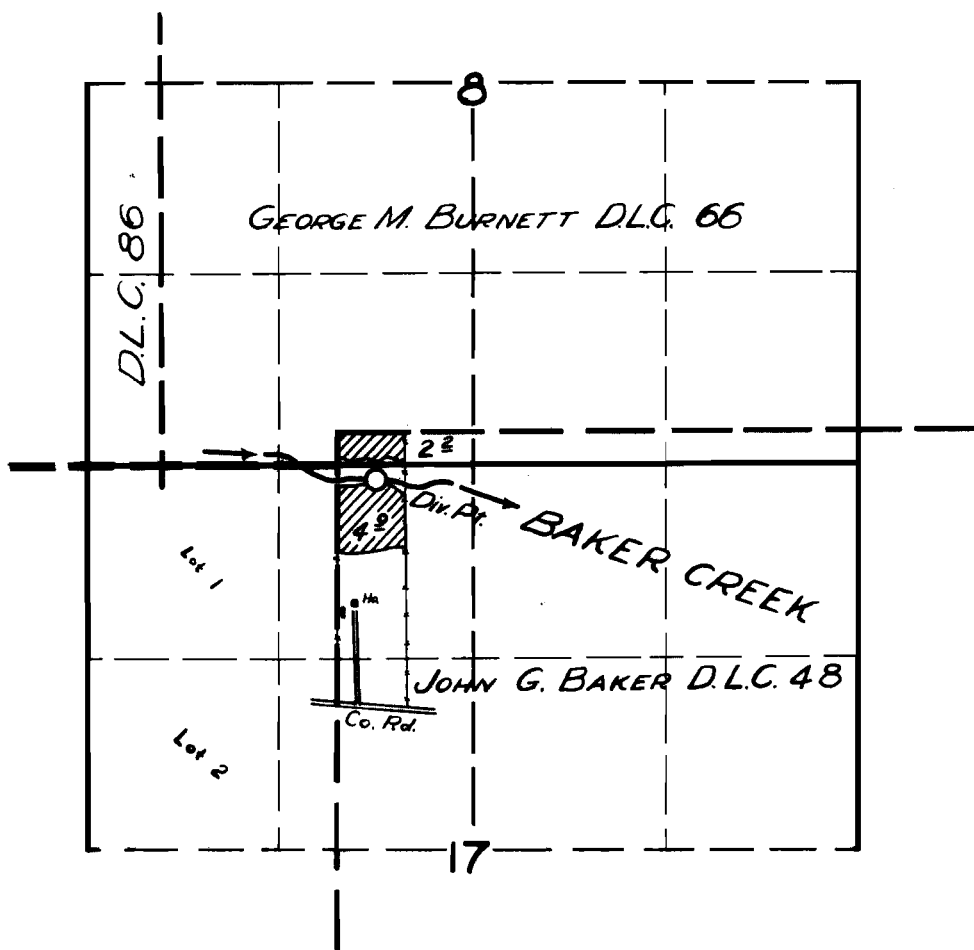

FINAL PROOF SURVEY

UNDER

Application No. 25160 Permit No. 19953

IN NAME OF

FRANCIS E. & ELIZABETH MARSH

Surveyed 26 Sep. 1955, by [Signature]

DFQ-5D-62