


T.11S, R.9W.W.M.

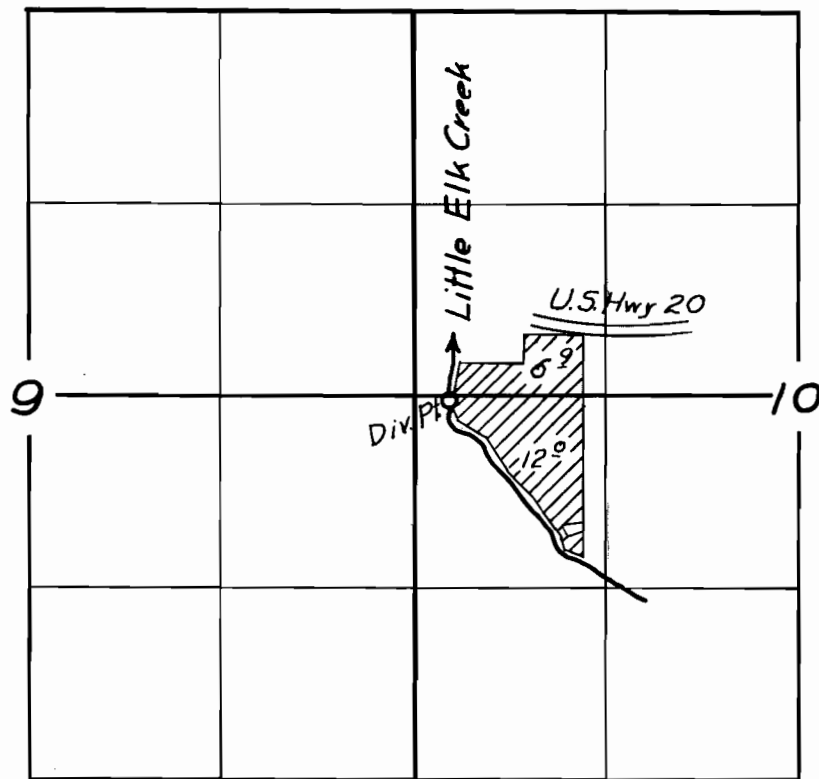

FINAL PROOF SURVEY

UNDER

Application No. ~~25849~~ Permit No. ~~20301~~

IN NAME OF

ERNEST E. GRAHAM

Surveyed 24 April 1955, by H. L. Coffman