


T.3 & 4 S., R. 2 W. W.M.

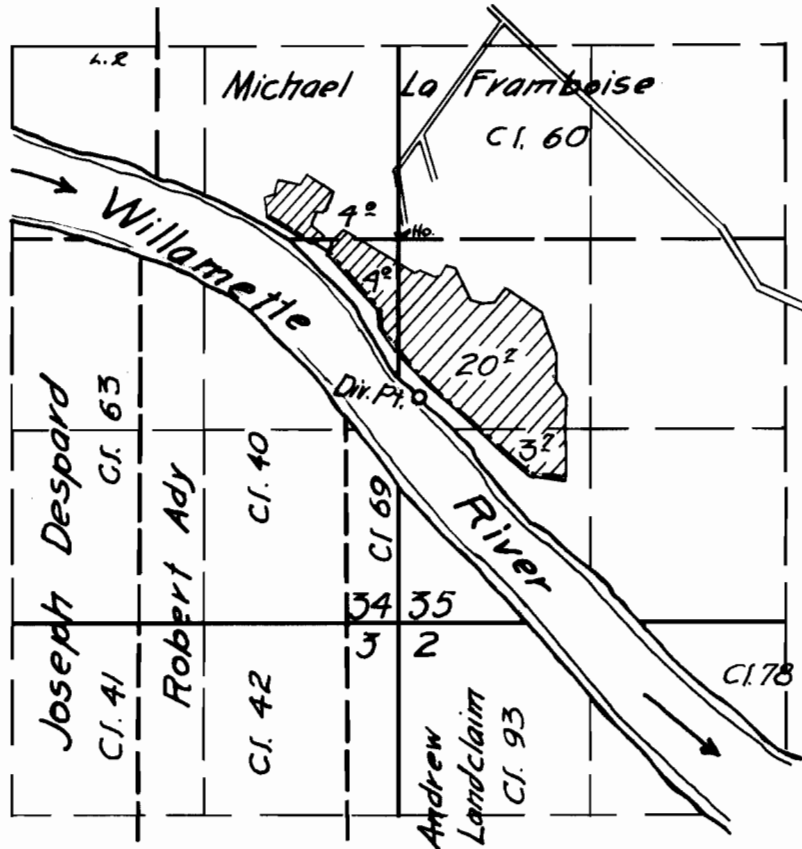

**FINAL PROOF SURVEY**

UNDER

Application No. 25989. Permit No. 20364.

IN NAME OF

**FRED W & MARJORIE R. WICKMAN**

Surveyed 20 Sept. 1955, by *Robert H. Reed*