


T. 3S.R. 9W.W.M.

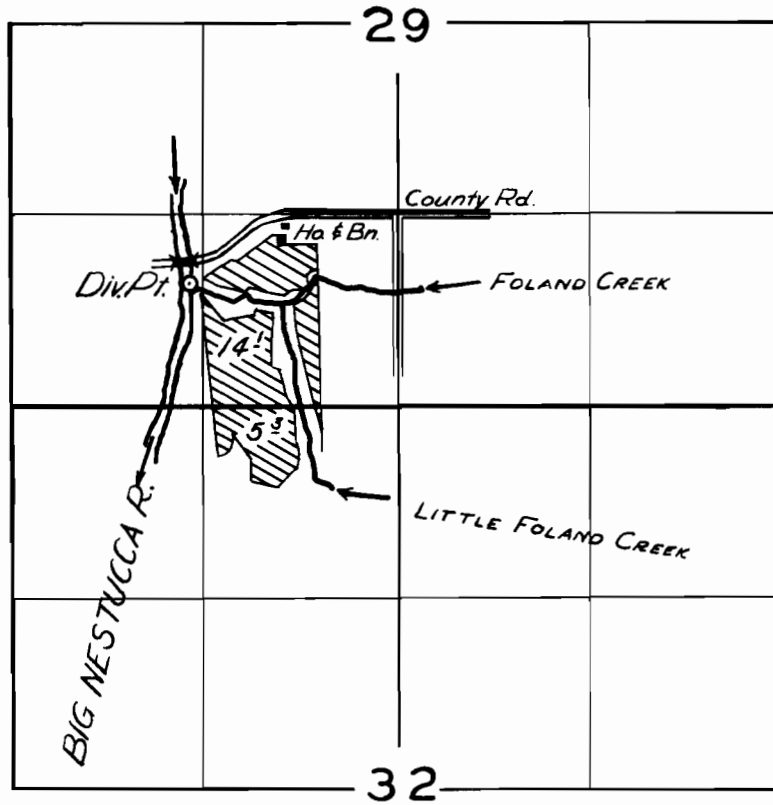

FINAL PROOF SURVEY

UNDER

Application No. 26099 Permit No. 20403

IN NAME OF

EDWIN WOODS

Surveyed 31 Aug. 1955, by R. A. Whitby

1955-E