


T.3S.R.9W.W.M.

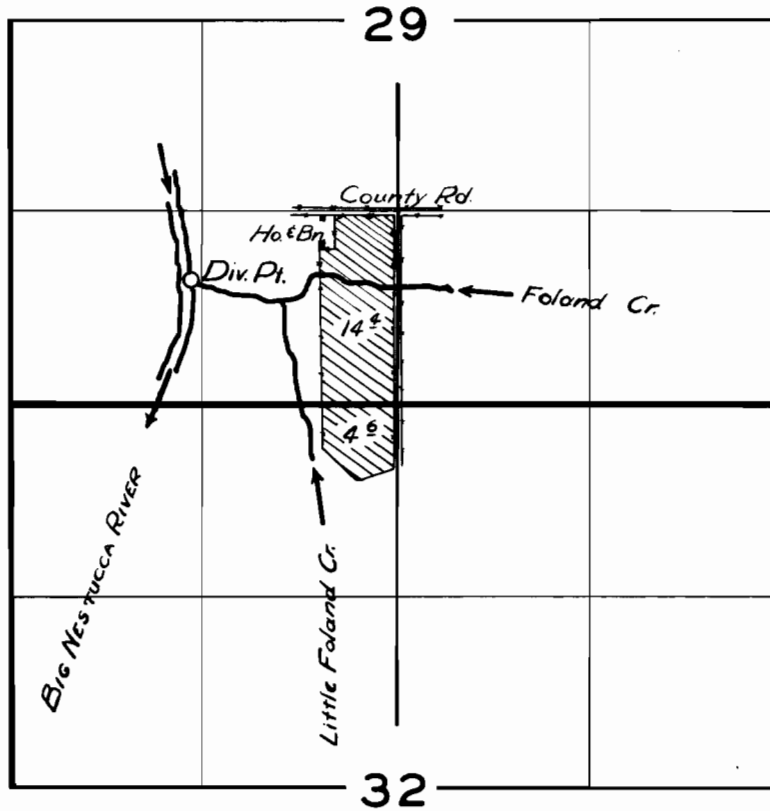

**FINAL PROOF SURVEY**

UNDER

Application No. 26098 Permit No. 20575

IN NAME OF

ELWIN M. STRONG

Surveyed 30, Aug. 1955, by *R. H. Whitby*

1955-E