


T. 10 S. R. 10 W. W. M.

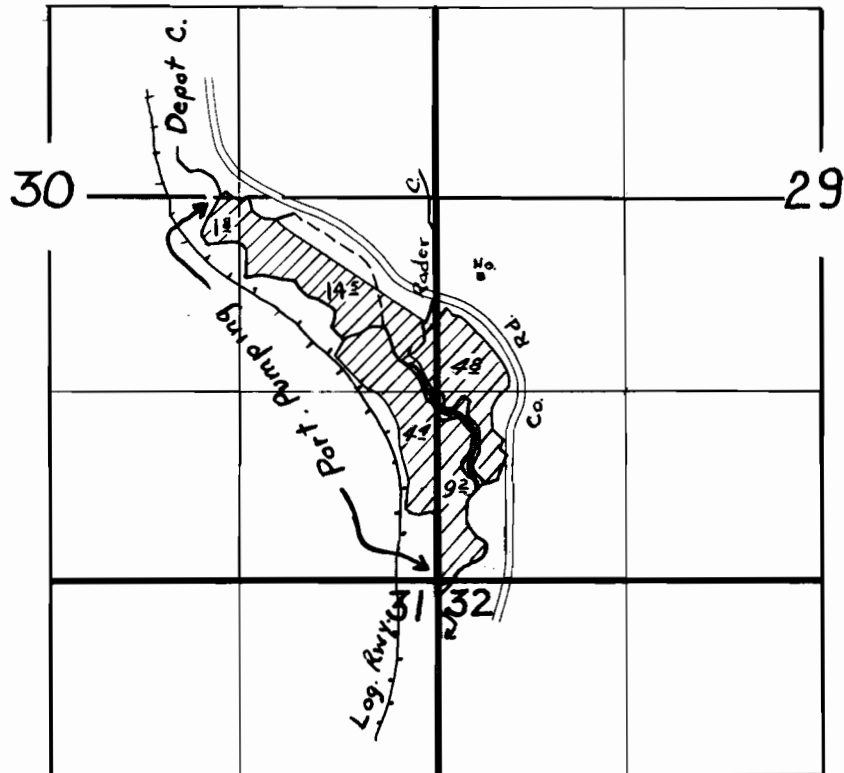

FINAL PROOF SURVEY
UNDER

Application No. 26337 Permit No. 20665
IN NAME OF

W. M. GRAVES

Surveyed 22 Apr. 1955, by H. Coffman