


T.17S, R.47E.WM

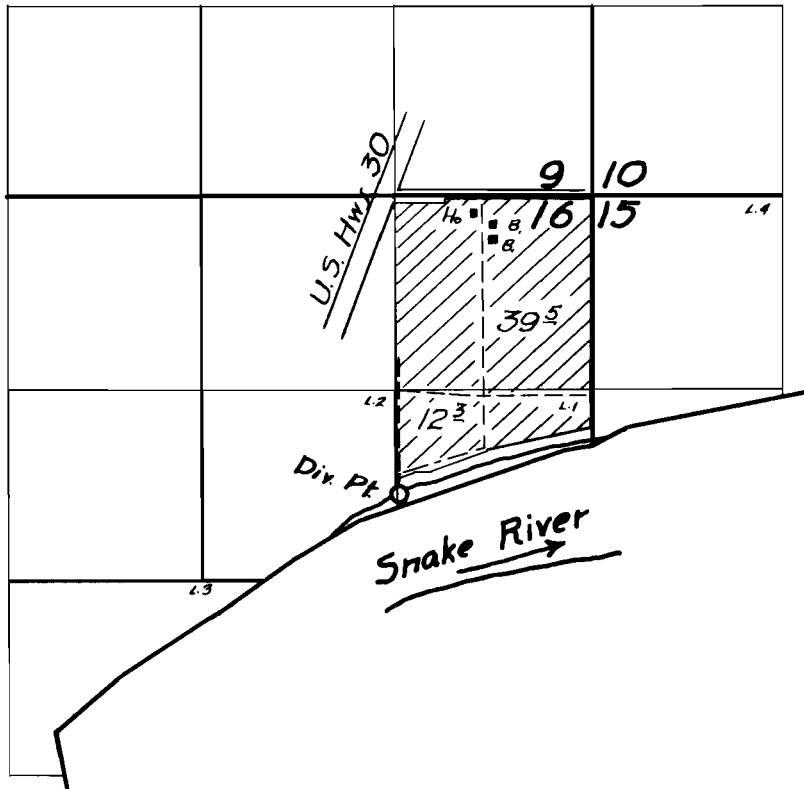

FINAL PROOF SURVEY
UNDER

Application No. ~~24946~~ Permit No. 20683...
IN NAME OF

M.B. & BERTHA TURNER SONNER

Surveyed 1 April 1955, by H.L. Coffman