


T I S R 9 W W M

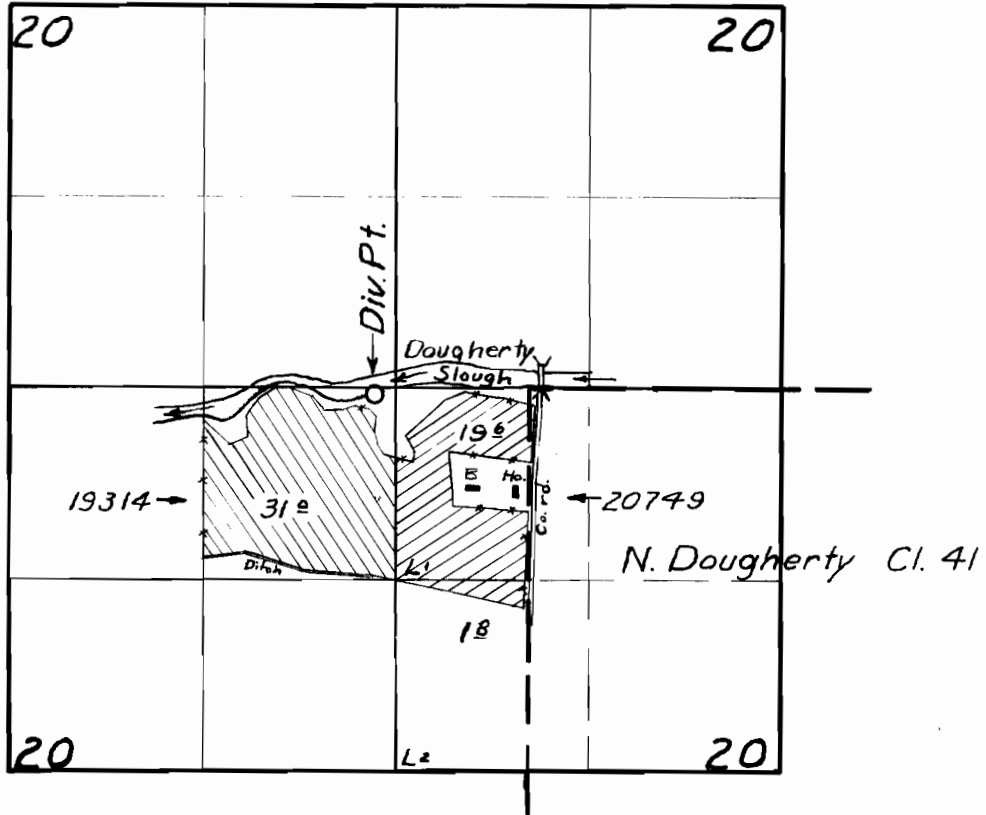

FINAL PROOF SURVEY

UNDER

24539

19314

Application No. 26467 Permit No. 20749

IN NAME OF

ALBERT BOHREN

Surveyed July 14 1955, by *M. Bish*