


T.17&18S. R.47E.W.M.

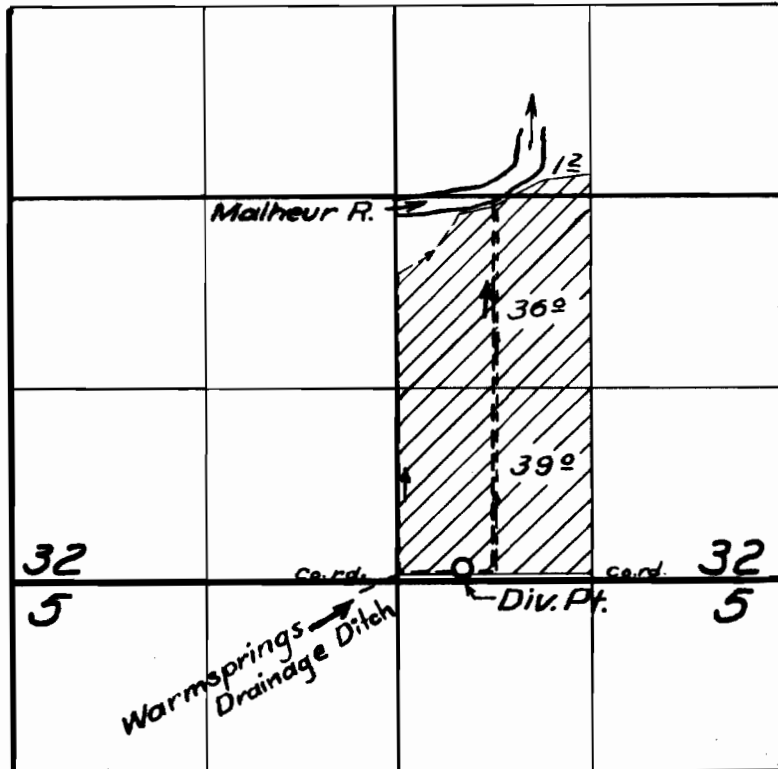

FINAL PROOF SURVEY
UNDER

Application No. 23782 Permit No. 20769
IN NAME OF

Thomas J. & Ethel M. Wells

Surveyed Oct. 7, 1955, by M. Bish