


T. 4S. R. 10W. W.M.

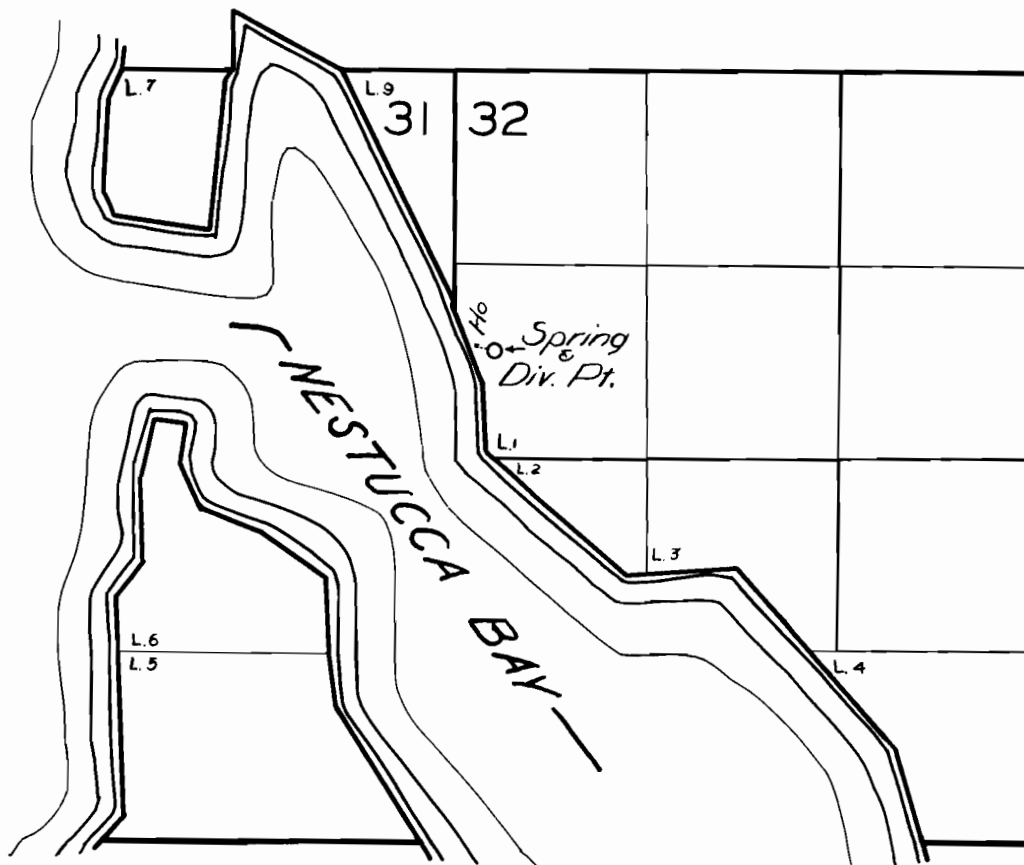

FINAL PROOF SURVEY
UNDER

Application No. 26546, Permit No. 20803
IN NAME OF

EDWARD G. & DOUGLASS C. RICHARDS

Surveyed 17 Aug -55, by *C. Whitely*

1955 - E