


T.4 S. R. 10W. W.M.

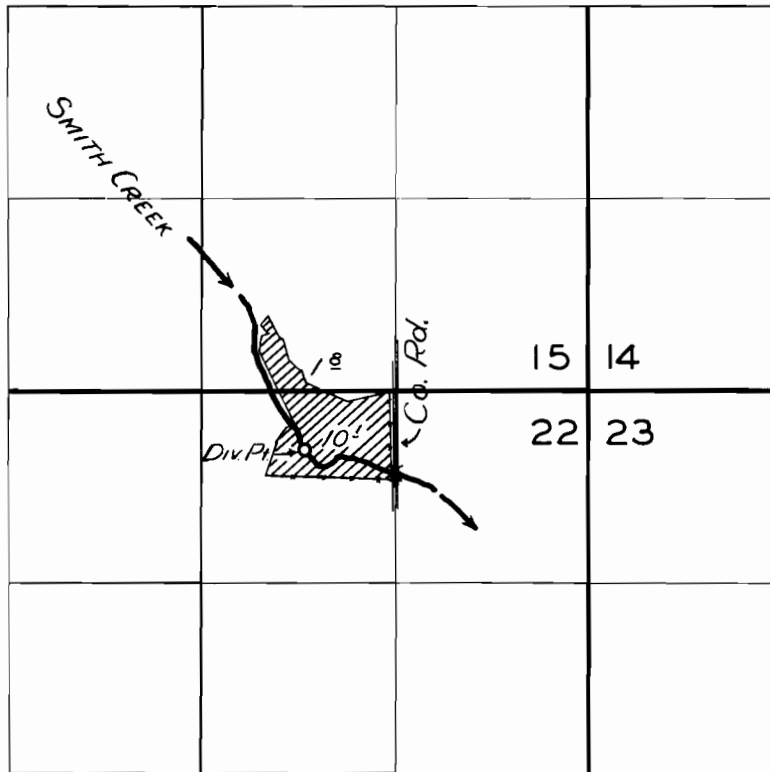

FINAL PROOF SURVEY

UNDER

Application No. 26615, Permit No. 20843

IN NAME OF

CHAS. PORTER

Surveyed 11 Aug. 1955, by